

City of Prince George

HISTORY SHEET

PID: - 028396642

Scale: 1:500

Legal: LOT 12

D.L.: - 1605

PLAN: - EPP8499

Address: - 2990 VISTA RIDGE DR

Sanitary Connection:# SIZE: 100mmØ MATERIAL PVC INV. 663.13m CONNECTED

Water Connection:# SIZE: 19mmØ MATERIAL: COPPER INV. 663.07m

Storm Connection:# SIZE 100mmØ MATERIAL PVC INV. 663.12m CONNECTED

Cash Receipt No's: WATER SANITARY STORM

CURB FROM PROPERTY LINE 5m PAVEMENT WIDTH 10m

B.C. HYDRO 75mm DB2 U/G CONNECTION

B.C. TELEPHONE 50mm DB2 U/G CONNECTION


TERASEN GAS 42 PROP /P.E

Information Sheets: REF. DWGS. L&M ENGINEERING LTD. JOB. 1106-06-04 DWGS. (001-306)

Comments: CS CURB STOP SDW WATER SERVICE TCH HYDRO SERVICE
CO CLEAN OUT STORM SERVICE CABLE SERVICE
SANITARY SERVICE TELECOMMUNICATIONS GAS GAS
E ELECTRICAL

THE INFORMATION CONTAINED HEREIN IS FOR INTERNAL USE ONLY.

NOT TO BE RELIED UPON UNLESS CONFIRMED BY THE SITE INSPECTION AND/OR INVESTIGATION

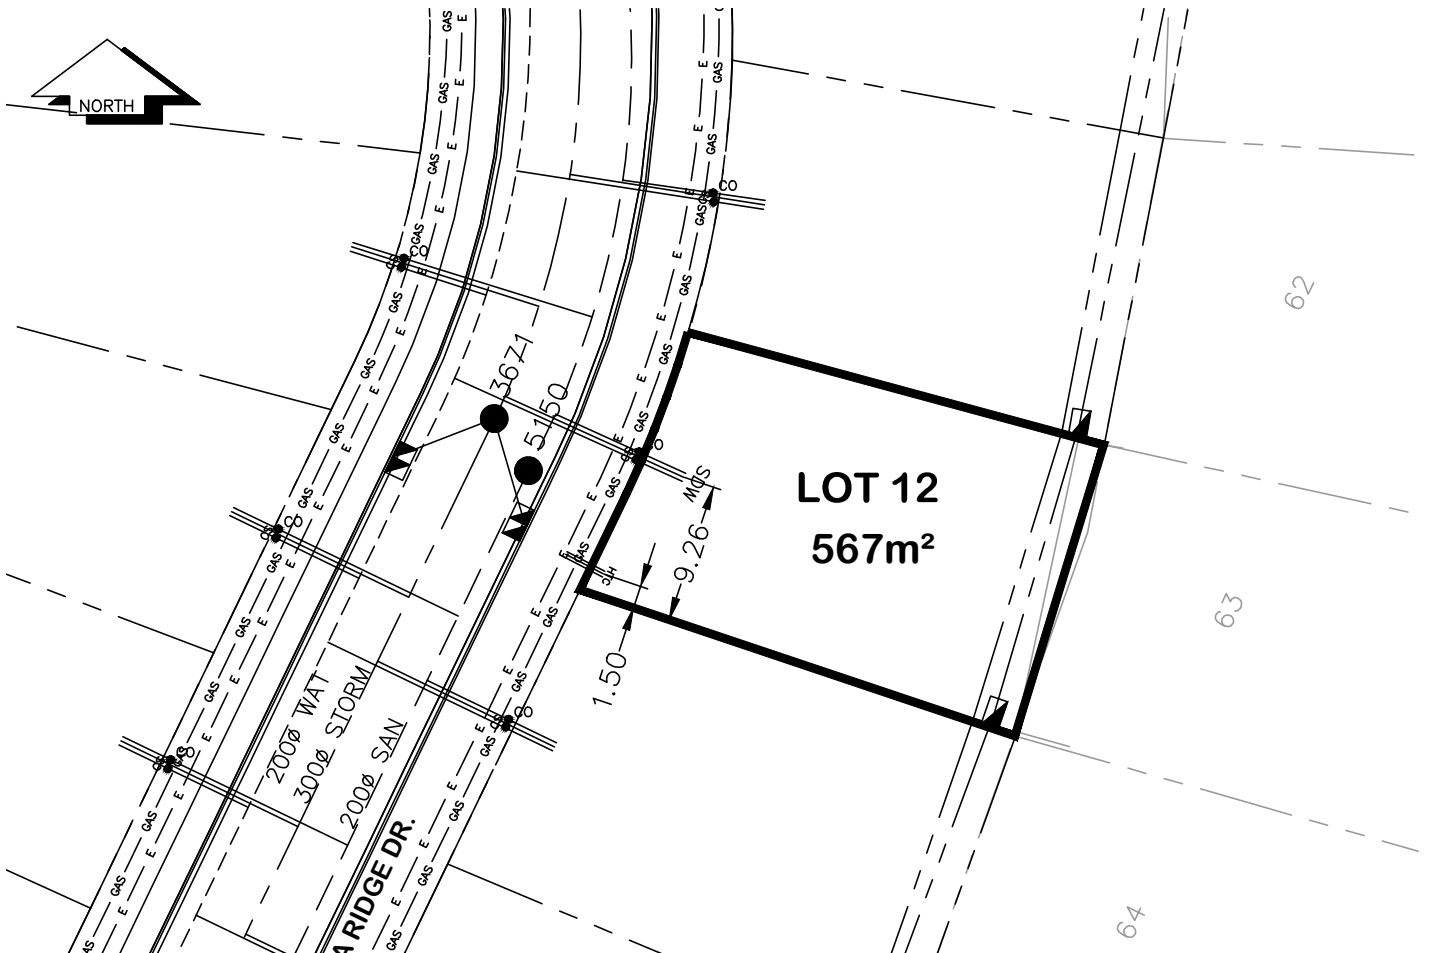

SANITARY, STORM & WATER SERVICE INVERTS	SANITARY	WATER	STORM
1. Distance from San. M.H. 5150 toward San. M.H. 4459 to lot service connection point is:	4.0m	N/A	N/A
1a.Distance from Stm. M.H.3671 toward Stm. M.H.3672 to lot service connection point is:	N/A	N/A	1.0m
2. Main Size at connection point is	200mmØ	200mmØ	300mmØ
3. Invert of main at conn. stub pt is	662.48m	661.94m	662.50m
4. Invert at service end is	663.13m	663.07m	663.12m
5. Cover at P/L in meters	2.47m	2.75m	2.47m
6. Survey Date: NOV,14,07Book Ref.: 1106-06-03By: FORESIGHT			

SANITARY HISTORY:

DATE INSTALLED: JULY 2010

INSTALLED BY: WESTERN INDUSTRIAL CONTRACTORS LTD

WATER HISTORY:

DATE INSTALLED: JULY 2010

INSTALLED BY: WESTERN INDUSTRIAL CONTRACTORS LTD

STORM HISTORY:

DATE INSTALLED: JULY 2010

INSTALLED BY: WESTERN INDUSTRIAL CONTRACTORS LTD