

City of Prince George

HISTORY SHEET

PID: - 028396651

Scale: 1:500

Legal: LOT 13

D.L.: - 1605

PLAN: - EPP8499

Address: - 2984 VISTA RIDGE DR

Sanitary Connection:# SIZE: 100mmØ MATERIAL PVC INV. 664.39m CONNECTED

Water Connection:# SIZE: 19mmØ MATERIAL: COPPER INV. 663.36m

Storm Connection:# SIZE 100mmØ MATERIAL PVC INV. 664.30m CONNECTED

Cash Receipt No's: WATER SANITARY STORM

CURB FROM PROPERTY LINE 5m PAVEMENT WIDTH 10m

B.C. HYDRO 75mm DB2 U/G CONNECTION

B.C. TELEPHONE 50mm DB2 U/G CONNECTION


TERASEN GAS 42 PROP /P.E

Information Sheets: REF. DWGS. L&M ENGINEERING LTD. JOB. 1106-06-04 DWGS. (001-306)

Comments: CS CURB STOP SDW WATER SERVICE SDW HYDRO SERVICE SDW CABLE SERVICE SDW TELECOMMUNICATIONS SDW GAS GAS CO CLEAN OUT SANITARY SERVICE E ELECTRICAL

THE INFORMATION CONTAINED HEREIN IS FOR INTERNAL USE ONLY.

NOT TO BE RELIED UPON UNLESS CONFIRMED BY THE SITE INSPECTION AND/OR INVESTIGATION

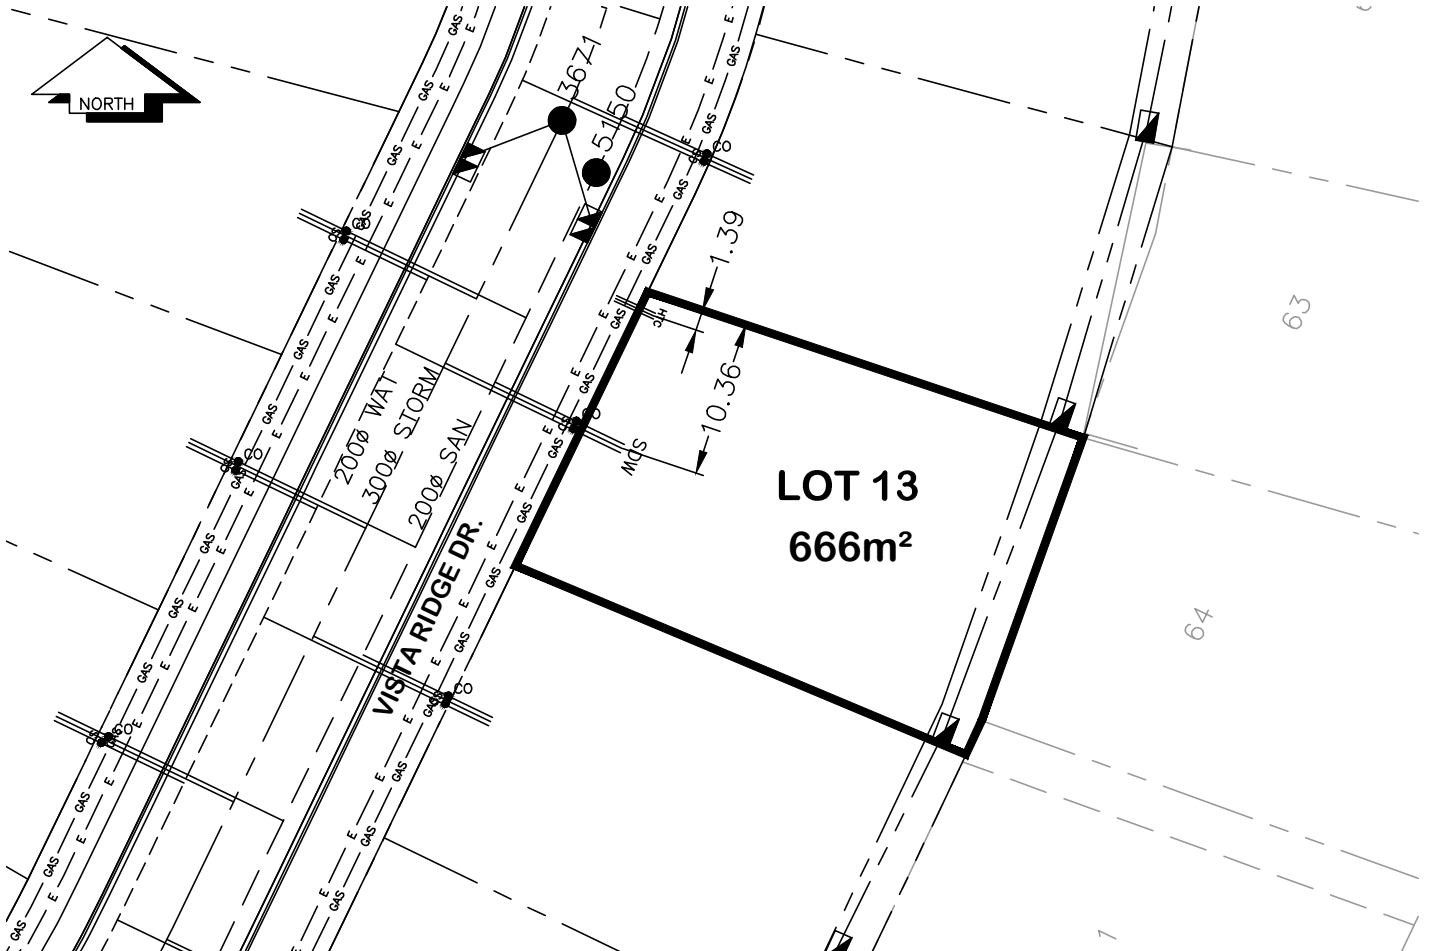

SANITARY, STORM & WATER SERVICE INVERTS	SANITARY	WATER	STORM
1. Distance from San. M.H.5150 toward San. M.H.5151 to lot service connection point is:	15.5m	N/A	N/A
1a.Distance from Stm. M.H.3671 toward Stm. M.H.3672 to lot service connection point is:	N/A	N/A	18.5m
2. Main Size at connection point is	200mmØ	200mmØ	300mmØ
3. Invert of main at conn. stub pt is	663.50m	663.45m	663.54m
4. Invert at service end is	664.39m	664.37m	664.40m
5. Cover at P/L in meters	2.45m	2.48m	2.33m
6. Survey Date: NOV,14,07Book Ref.: 1106-06-03By: FORESIGHT			

SANITARY HISTORY:

DATE INSTALLED: JULY 2010

INSTALLED BY: WESTERN INDUSTRIAL CONTRACTORS LTD

WATER HISTORY:

DATE INSTALLED: JULY 2010

INSTALLED BY: WESTERN INDUSTRIAL CONTRACTORS LTD

STORM HISTORY:

DATE INSTALLED: JULY 2010

INSTALLED BY: WESTERN INDUSTRIAL CONTRACTORS LTD
