

City of Prince George

HISTORY SHEET

PID: - 028396677

Scale: 1:500

Legal: LOT 15

D.L.: - 1605

PLAN: - EPP8499

Address: - 2972 VISTA RIDGE DR

Sanitary Connection:# SIZE: 100mmØ MATERIAL: PVC INV. 667.34m CONNECTED

Water Connection:# SIZE: 19mmØ MATERIAL: COPPER INV. 667.33m

Storm Connection:# SIZE: 100mmØ MATERIAL: PVC INV. 667.36m CONNECTED

Cash Receipt No's: WATER SANITARY STORM

CURB FROM PROPERTY LINE 5m PAVEMENT WIDTH 10m

B.C. HYDRO 75mm DB2 U/G CONNECTION

B.C. TELEPHONE 50mm DB2 U/G CONNECTION


TERASEN GAS 42 PROP /P.E

Information Sheets: REF. DWGS. L&M ENGINEERING LTD. JOB. 1106-06-04 DWGS. (001-306)

Comments: CS CURB STOP SDW WATER SERVICE SDW HYDRO SERVICE SDW CABLE SERVICE SDW TELECOMMUNICATIONS CO CLEAN OUT GAS GAS E ELECTRICAL

THE INFORMATION CONTAINED HEREIN IS FOR INTERNAL USE ONLY.

NOT TO BE RELIED UPON UNLESS CONFIRMED BY THE SITE INSPECTION AND/OR INVESTIGATION

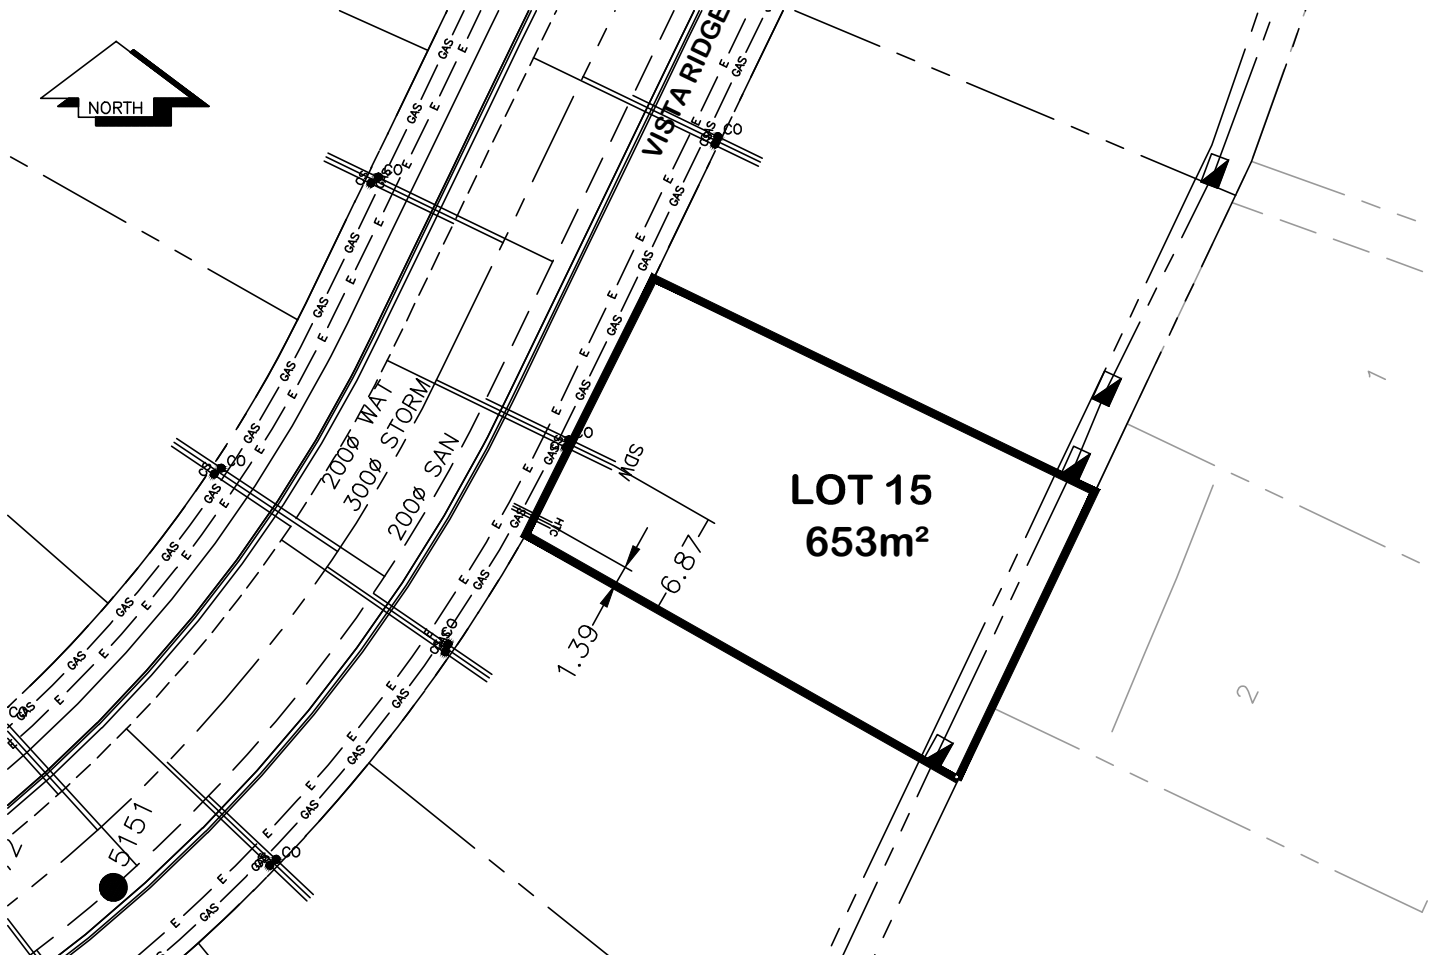

SANITARY, STORM & WATER SERVICE INVERTS	SANITARY	WATER	STORM
1. Distance from San. M.H. 5150 toward San. M.H. 5151 to lot service connection point is:	53.0m	N/A	N/A
1a.Distance from Stm. M.H. 3671 toward Stm. M.H.3672 to lot service connection point is:	N/A	N/A	60.0m
2. Main Size at connection point is	200mmØ	200mmØ	300mmØ
3. Invert of main at conn. stub pt is	666.08m	666.78m	666.22m
4. Invert at service end is	667.34m	667.33m	667.36m
5. Cover at P/L in meters	2.55m	2.65m	2.52m
6. Survey Date: NOV,14,07Book Ref.: 1106-06-03By: FORESIGHT			

SANITARY HISTORY:

DATE INSTALLED: JULY 2010

INSTALLED BY: WESTERN INDUSTRIAL CONTRACTORS LTD

WATER HISTORY:

DATE INSTALLED: JULY 2010

INSTALLED BY: WESTERN INDUSTRIAL CONTRACTORS LTD

STORM HISTORY:

DATE INSTALLED: JULY 2010

INSTALLED BY: WESTERN INDUSTRIAL CONTRACTORS LTD