

# City of Prince George

## HISTORY SHEET

PID: - 028396685

Scale: 1:500

Legal: LOT 16

D.L.: - 1605

PLAN: - EPP8499

Address: - 2966 VISTA RIDGE DR

Sanitary Connection:# SIZE: 100mmØ MATERIAL PVC INV. 668.33m CONNECTED

Water Connection:# SIZE: 19mmØ MATERIAL: COPPER INV. 668.33m

Storm Connection:# SIZE 100mmØ MATERIAL PVC INV. 668.35 CONNECTED

Cash Receipt No's: WATER SANITARY STORM

CURB FROM PROPERTY LINE 5m PAVEMENT WIDTH 10m

B.C. HYDRO 75mm DB2 U/G CONNECTION

B.C. TELEPHONE 50mm DB2 U/G CONNECTION


TERASEN GAS 42 PROP /P.E

Information Sheets: REF. DWGS. L&M ENGINEERING LTD. JOB. 1106-06-04 DWGS. (001-306)

Comments: CS CURB STOP SDW WATER SERVICE TOH HYDRO SERVICE  
CO CLEAN OUT STORM SERVICE CABLE SERVICE  
SANITARY SERVICE TELECOMMUNICATIONS GAS GAS  
E ELECTRICAL

THE INFORMATION CONTAINED HEREIN IS FOR INTERNAL USE ONLY.

NOT TO BE RELIED UPON UNLESS CONFIRMED BY THE SITE INSPECTION AND/OR INVESTIGATION

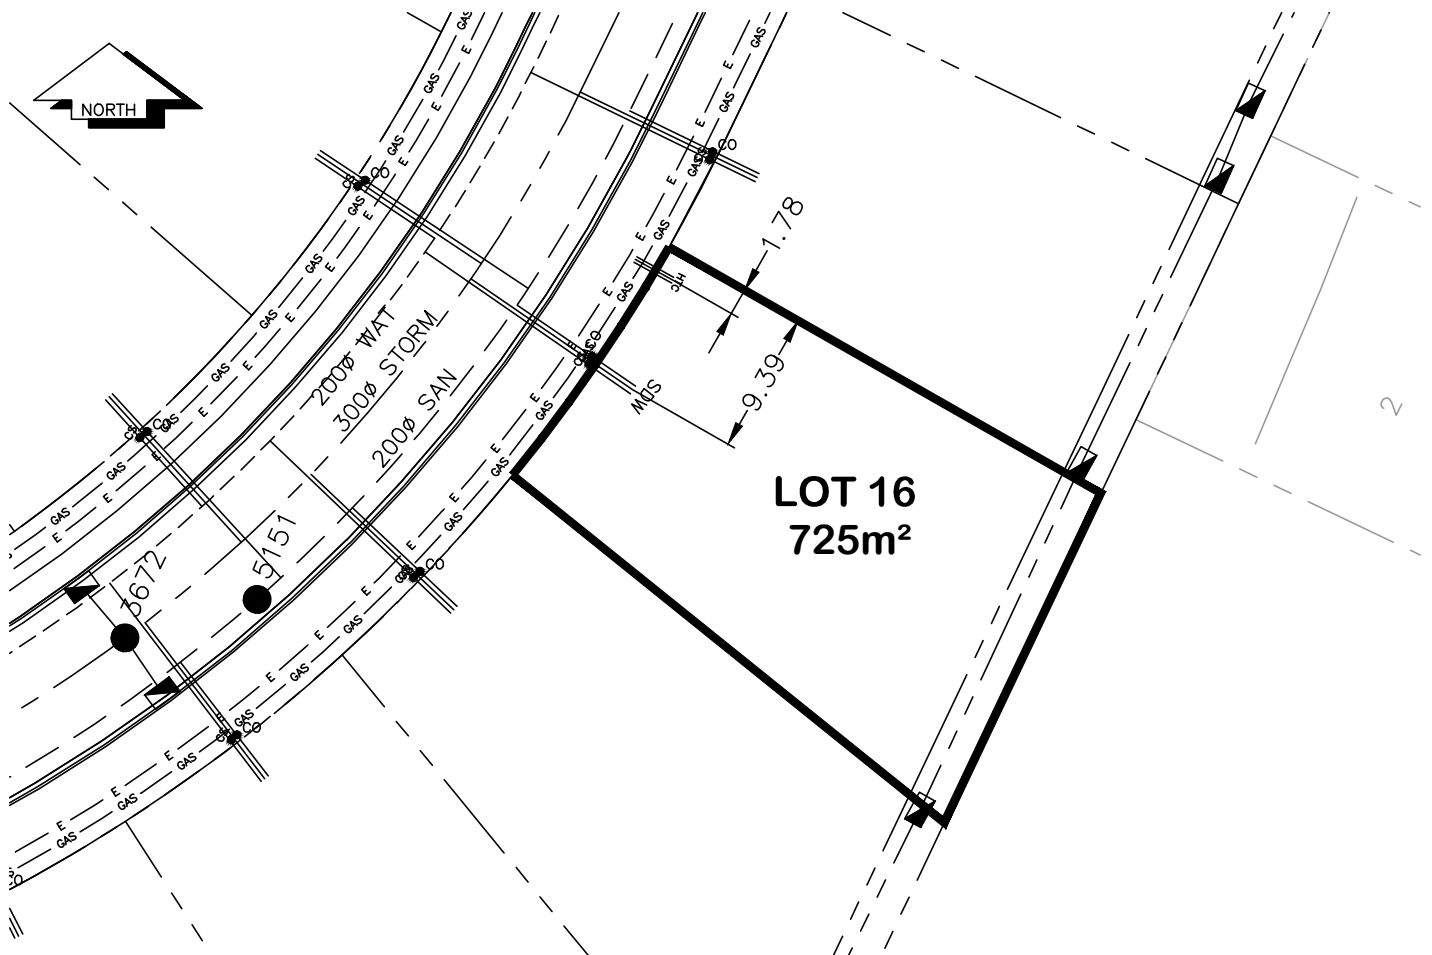

SANITARY, STORM & WATER SERVICE INVERTS	SANITARY	WATER	STORM
1. Distance from San. M.H. 3672 toward San. M.H.3671 to lot service connection point is:	26.0m	N/A	N/A
1a.Distance from Stm. M.H.5151 toward Stm. M.H.5150 to lot service connection point is:	N/A	N/A	33.0m
2. Main Size at connection point is	200mmØ	200mmØ	300mmØ
3. Invert of main at conn. stub pt is	667.01m	667.68m	668.91m
4. Invert at service end is	668.33m	668.33m	668.35m
5. Cover at P/L in meters	2.42m	2.47m	2.35m
6. Survey Date: NOV,14,07Book Ref.: 1106-06-03By: FORESIGHT			

**SANITARY HISTORY:**

**DATE INSTALLED: JULY 2010**

**INSTALLED BY: WESTERN INDUSTRIAL CONTRACTORS LTD**

---

---

**WATER HISTORY:**

**DATE INSTALLED: JULY 2010**

**INSTALLED BY: WESTERN INDUSTRIAL CONTRACTORS LTD**

---

---

**STORM HISTORY:**

**DATE INSTALLED: JULY 2010**

**INSTALLED BY: WESTERN INDUSTRIAL CONTRACTORS LTD**

---

---

