

City of Prince George

HISTORY SHEET

PID: - 028396693 Scale: 1:500

Legal: LOT 17 D.L.: - 1605 PLAN: - EPP8499

Address: - 2960 VISTA RIDGE DR

Sanitary Connection:# SIZE: 100mmØ MATERIAL PVC INV. 669.79m CONNECTED

Water Connection:# SIZE: 19mmØ MATERIAL: COPPER INV. 669.78m

Storm Connection:# SIZE 100mmØ MATERIAL PVC INV. 669.75m CONNECTED

Cash Receipt No's: WATER SANITARY STORM

CURB FROM PROPERTY LINE 5m PAVEMENT WIDTH 10m

B.C. HYDRO 75mm DB2 U/G CONNECTION ✓


B.C. TELEPHONE 50mm DB2 U/G CONNECTION ✓

TERASEN GAS 42 PROP /P.E

Information Sheets: REF. DWGS. L&M ENGINEERING LTD. JOB. 1106-06-04 DWGS. (001-306)

Comments: CS CURB STOP SDW WATER SERVICE SDW HYDRO SERVICE SDW CABLE SERVICE SDW TELECOMMUNICATIONS CO CLEAN OUT GAS GAS E ELECTRICAL

THE INFORMATION CONTAINED HEREIN IS FOR INTERNAL USE ONLY.
NOT TO BE RELIED UPON UNLESS CONFIRMED BY THE SITE INSPECTION AND/OR INVESTIGATION

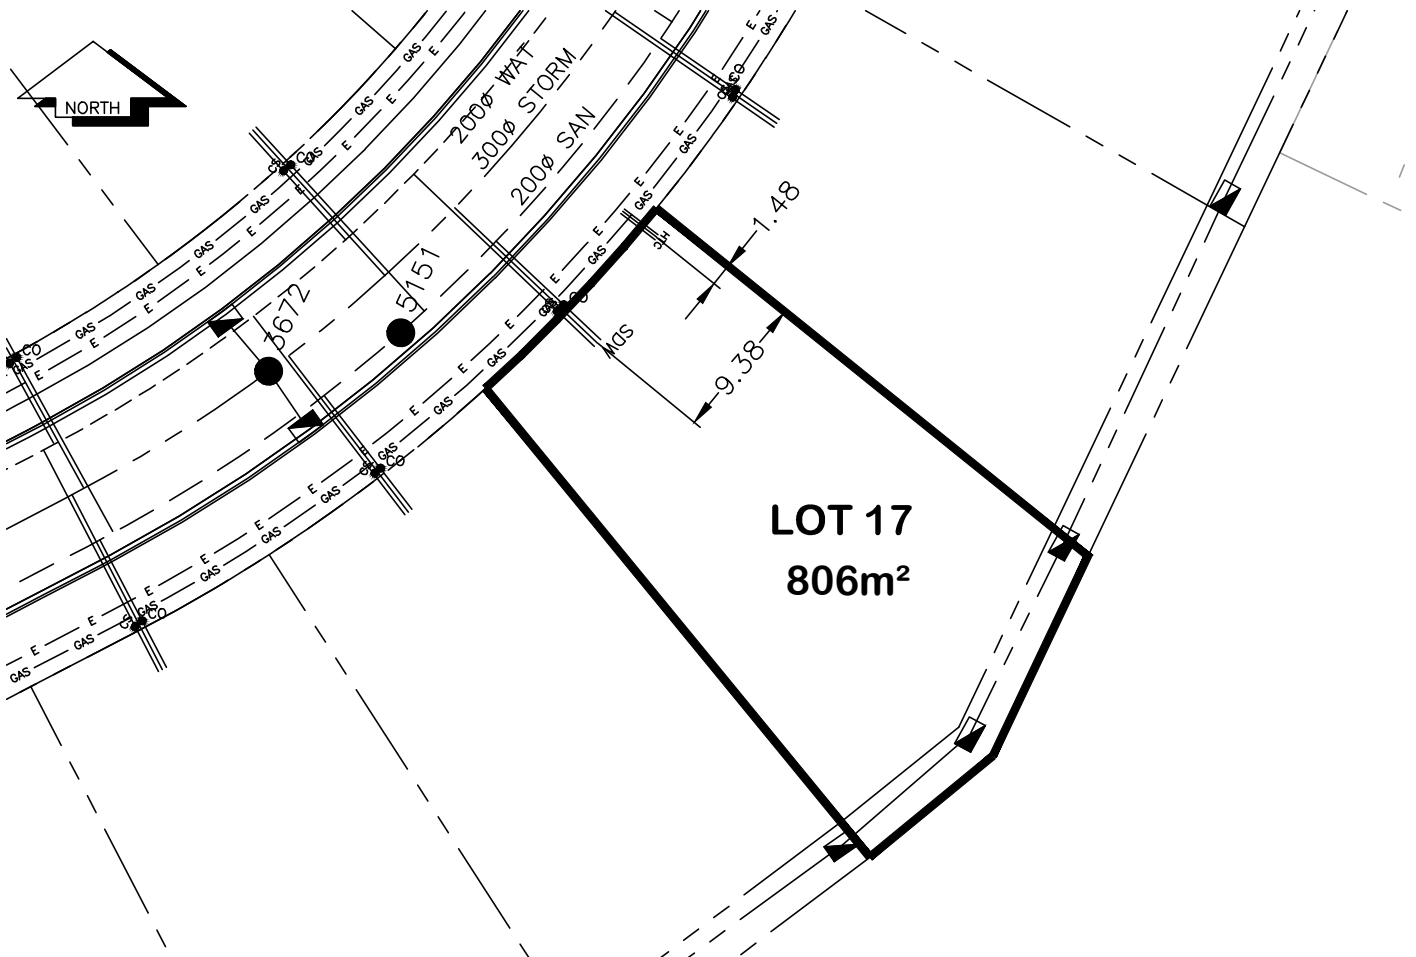

SANITARY, STORM & WATER SERVICE INVERTS	SANITARY	WATER	STORM
1. Distance from San. M.H. 5151 toward San. M.H. 5150 to lot service connection point is:	8.5m	N/A	N/A
1a.Distance from Stm. M.H.3672 toward Stm. M.H. 3671 to lot service connection point is:	N/A	N/A	16.5m
2. Main Size at connection point is	200mmØ	200mmØ	300mmØ
3. Invert of main at conn. stub pt is	668.08m	668.65m	668.12m
4. Invert at service end is	669.79m	669.78m	669.75m
5. Cover at P/L in meters	2.54m	2.57m	2.51m
6. Survey Date: NOV,14,07Book Ref.: 1106-06-03By: FORESIGHT			

SANITARY HISTORY:

DATE INSTALLED: JULY 2010

INSTALLED BY: WESTERN INDUSTRIAL CONTRACTORS LTD

WATER HISTORY:

DATE INSTALLED: JULY 2010

INSTALLED BY: WESTERN INDUSTRIAL CONTRACTORS LTD

STORM HISTORY:

DATE INSTALLED: JULY 2010

INSTALLED BY: WESTERN INDUSTRIAL CONTRACTORS LTD