

City of Prince George

HISTORY SHEET

PID: — 028396707

Scale: 1:500

Legal: LOT18

D.L.: — 1605

PLAN: — EPP8499

Address: — 2954 VISTA RIDGE DR

Sanitary Connection: # SIZE: 100mmØ MATERIAL PVC INV. 670.66m CONNECTED

Water Connection: # SIZE: 19mmØ MATERIAL: COPPER INV. 670.64m

Storm Connection: # SIZE 100mmØ MATERIAL PVC INV. 670.66m CONNECTED

Cash Receipt No's: WATER SANITARY STORM

CURB FROM PROPERTY LINE 5m PAVEMENT WIDTH 10m

B.C. HYDRO 75mm DB2 U/G CONNECTION ✓

B.C. TELEPHONE 50mm DB2 U/G CONNECTION ✓


TERASEN GAS 42 PROP /P.E

Information Sheets: REF. DWGS. L&M ENGINEERING LTD. JOB. 1106-06-04 DWGS. (001-306)

Comments: CS CURB STOP SDW WATER SERVICE HYDRO SERVICE GAS GAS
CO CLEAN OUT SDW STORM SERVICE CABLE SERVICE E ELECTRICAL
SDW SANITARY SERVICE TELECOMMUNICATIONS

THE INFORMATION CONTAINED HEREIN IS FOR INTERNAL USE ONLY.

NOT TO BE RELIED UPON UNLESS CONFIRMED BY THE SITE INSPECTION AND/OR INVESTIGATION

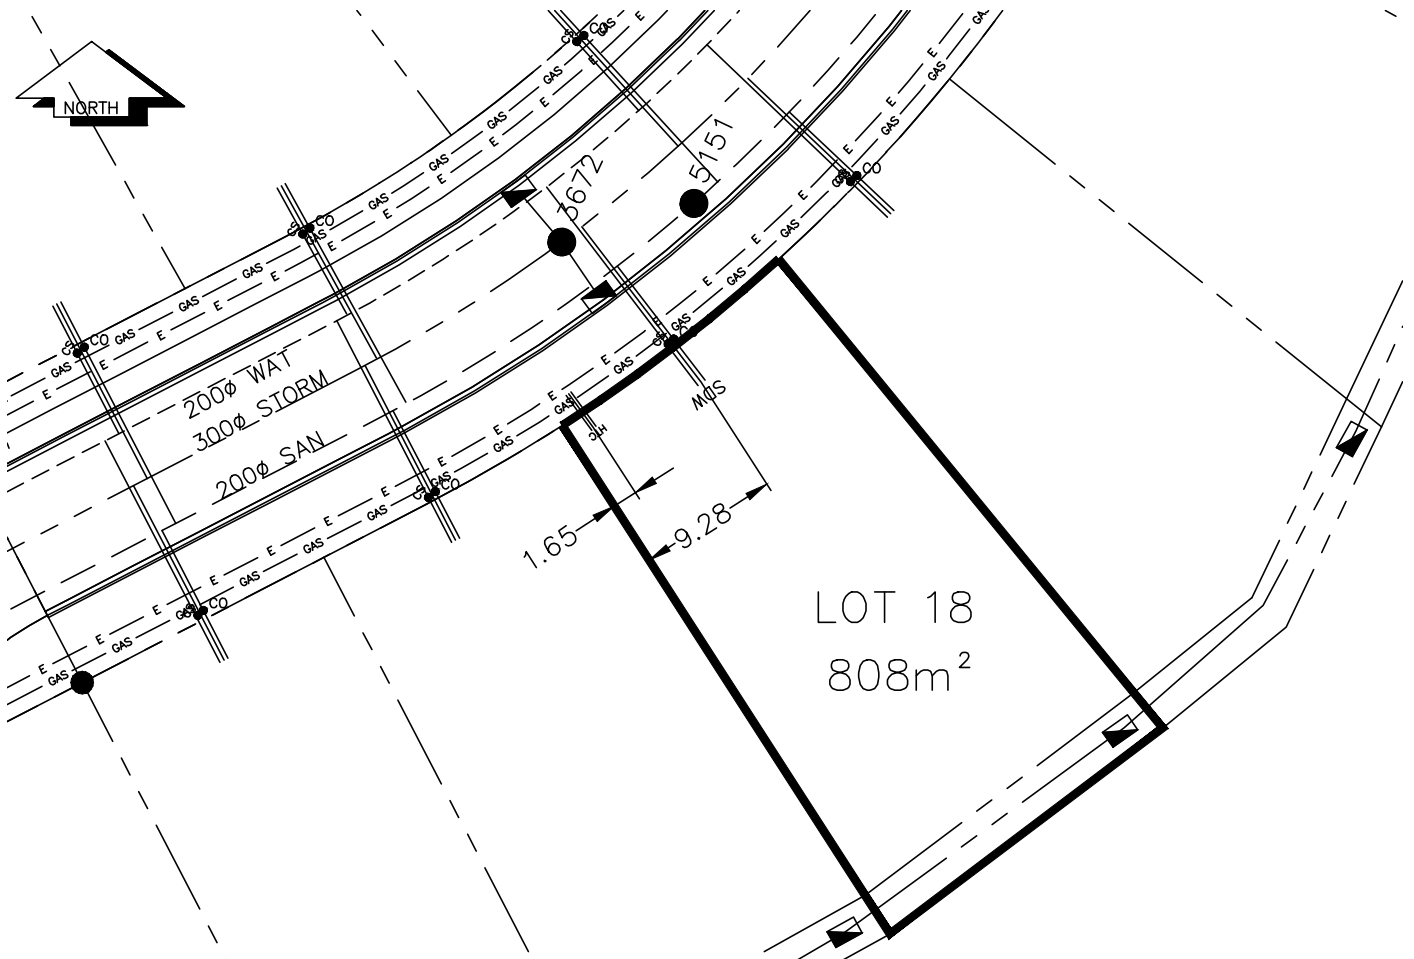

SANITARY, STORM & WATER SERVICE INVERTS	SANITARY	WATER	STORM
1. Distance from San. M.H. 5151 toward San. M.H.STUB to lot service connection point is:	6.5m	N/A	N/A
1a.Distance from Stm. M.H.3672 toward Stm. M.H.3671 to lot service connection point is:	N/A	N/A	1.5m
2. Main Size at connection point is	200mmØ	200mmØ	300mmØ
3. Invert of main at conn. stub pt is	668.84m	669.50m	668.98m
4. Invert at service end is	670.66m	670.64m	670.66m
5. Cover at P/L in meters	2.40m	2.53m	2.40m
6. Survey Date: NOV,14,07Book Ref.: 1106-06-03By: FORESIGHT			

SANITARY HISTORY:

DATE INSTALLED: JULY 2010

INSTALLED BY: WESTERN INDUSTRIAL CONTRACTORS LTD

WATER HISTORY:

DATE INSTALLED: JULY 2010

INSTALLED BY: WESTERN INDUSTRIAL CONTRACTORS LTD

STORM HISTORY:

DATE INSTALLED: JULY 2010

INSTALLED BY: WESTERN INDUSTRIAL CONTRACTORS LTD