

City of Prince George

HISTORY SHEET

PID: — 028396715

Scale: 1:500

Legal: LOT 19

D.L.: — 1605

PLAN: — EPP8499

Address: — 2948 VISTA RIDGE DR

Sanitary Connection: # SIZE: 100mmØ MATERIAL PVC INV. 671.48m CONNECTED

Water Connection: # SIZE: 19mmØ MATERIAL: COPPER INV. 671.46m

Storm Connection: # SIZE 100mmØ MATERIAL PVC INV. 671.48m CONNECTED

Cash Receipt No's: WATER SANITARY STORM

CURB FROM PROPERTY LINE 6m PAVEMENT WIDTH 13m

B.C. HYDRO 75mm DB2 U/G CONNECTION ✓

B.C. TELEPHONE 50mm DB2 U/G CONNECTION ✓


TERASEN GAS 42 PROP /P.E

Information Sheets: REF. DWGS. L&M ENGINEERING LTD. JOB. 1106-06-04 DWGS. (001-306)

Comments: CS CURB STOP SDW WATER SERVICE HYDRO SERVICE GAS GAS
CO CLEAN OUT STORM SERVICE CABLE SERVICE E ELECTRICAL
SANITARY SERVICE TELECOMMUNICATIONS

THE INFORMATION CONTAINED HEREIN IS FOR INTERNAL USE ONLY.

NOT TO BE RELIED UPON UNLESS CONFIRMED BY THE SITE INSPECTION AND/OR INVESTIGATION

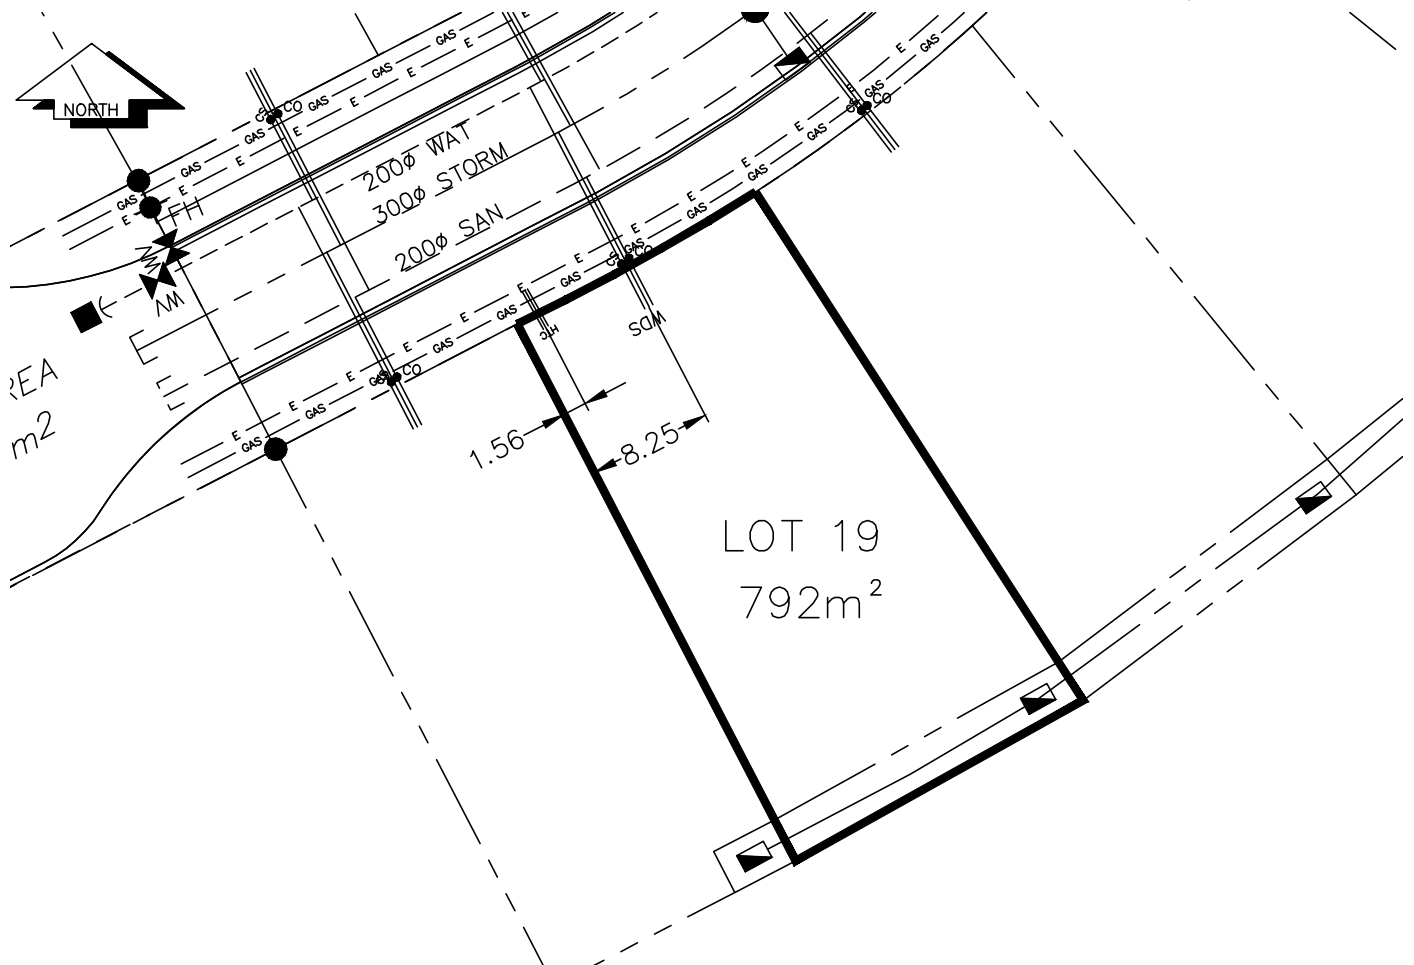

SANITARY, STORM & WATER SERVICE INVERTS	SANITARY	WATER	STORM
1. Distance from San. M.H. 5151 toward San. M.H.STUB to lot service connection point is:	24.5m	N/A	N/A
1a.Distance from Stm. M.H.3672 toward Stm. M.H.STUB to lot service connection point is:	N/A	N/A	15.5m
2. Main Size at connection point is	200mmØ	200mmØ	300mmØ
3. Invert of main at conn. stub pt is	669.55m	670.15m	669.65m
4. Invert at service end is	671.48m	671.46m	671.48m
5. Cover at P/L in meters	2.38m	2.47m	2.38m
6. Survey Date: NOV,14,07Book Ref.: 1106-06-03By: FORESIGHT			

SANITARY HISTORY:

DATE INSTALLED: JULY 2010

INSTALLED BY: WESTERN INDUSTRIAL CONTRACTORS LTD

WATER HISTORY:

DATE INSTALLED: JULY 2010

INSTALLED BY: WESTERN INDUSTRIAL CONTRACTORS LTD

STORM HISTORY:

DATE INSTALLED: JULY 2010

INSTALLED BY: WESTERN INDUSTRIAL CONTRACTORS LTD
