

City of Prince George

HISTORY SHEET

PID: — 028396723

Scale: 1:500

Legal: LOT 20

D.L.: — 1605

PLAN: — EPP8499

Address: — 2942 VISTA RIDGE DR

Sanitary Connection: # SIZE: 100mm \emptyset MATERIAL PVC INV. 672.05m CONNECTED

Water Connection: # SIZE: 19mm \emptyset MATERIAL: COPPER INV. 671.95m

Storm Connection: # SIZE 100mm \emptyset MATERIAL PVC INV. 672.00m CONNECTED

Cash Receipt No's: WATER SANITARY STORM

CURB FROM PROPERTY LINE 5m PAVEMENT WIDTH 13m

B.C. HYDRO 75mm DB2 U/G CONNECTION ✓

B.C. TELEPHONE 50mm DB2 U/G CONNECTION ✓


TERASEN GAS 42 PROP /P.E

Information Sheets: REF. DWGS. L&M ENGINEERING LTD. JOB. 1106-06-04 DWGS. (001-306)

Comments: CS CURB STOP SDW WATER SERVICE HYDRO SERVICE
CO CLEAN OUT STORM SERVICE CABLE SERVICE
SANITARY SERVICE TELECOMMUNICATIONS GAS ELECTRICAL

THE INFORMATION CONTAINED HEREIN IS FOR INTERNAL USE ONLY.

NOT TO BE RELIED UPON UNLESS CONFIRMED BY THE SITE INSPECTION AND/OR INVESTIGATION

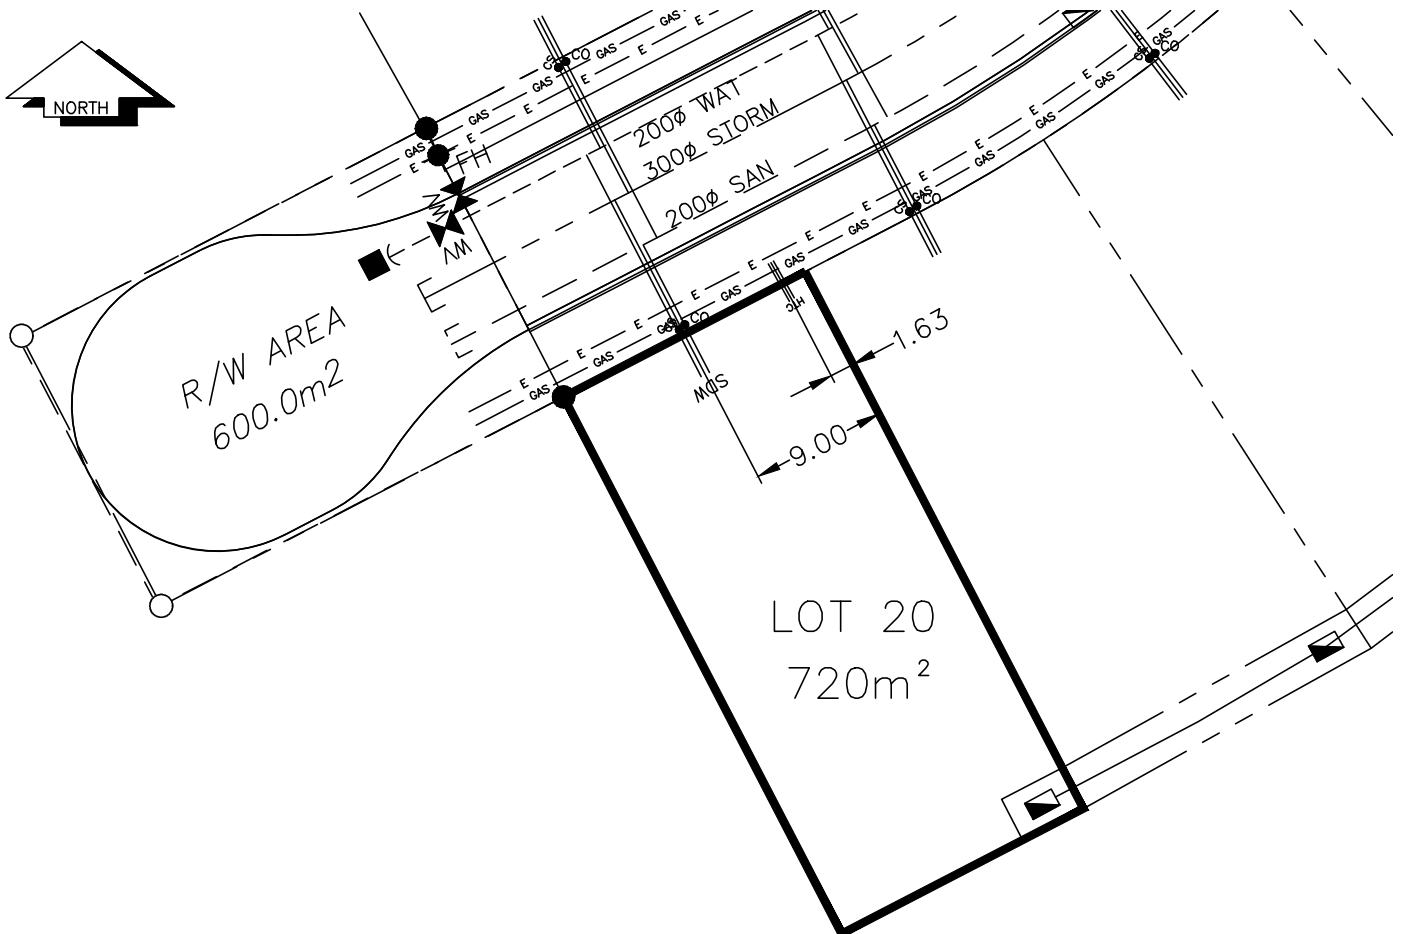

SANITARY, STORM & WATER SERVICE INVERTS	SANITARY	WATER	STORM
1. Distance from San. M.H.5151 toward San. M.H.STUB to lot service connection point is:	42.0m	N/A	N/A
1a.Distance from Stm. M.H.3672 toward Stm. M.H.STUB to lot service connection point is:	N/A	N/A	33.0m
2. Main Size at connection point is	200mmØ	200mmØ	300mmØ
3. Invert of main at conn. stub pt is	670.22m	670.76m	670.24m
4. Invert at service end is	672.05m	671.95m	672.00m
5. Cover at P/L in meters	2.36m	2.56m	2.36m
6. Survey Date: NOV,14,07Book Ref.: 1106-06-03By: FORESIGHT			

SANITARY HISTORY:

DATE INSTALLED: JULY 2010

INSTALLED BY: WESTERN INDUSTRIAL CONTRACTORS LTD

WATER HISTORY:

DATE INSTALLED: JULY 2010

INSTALLED BY: WESTERN INDUSTRIAL CONTRACTORS LTD

STORM HISTORY:

DATE INSTALLED: JULY 2010

INSTALLED BY: WESTERN INDUSTRIAL CONTRACTORS LTD