

City of Prince George HISTORY SHEET

PID: 028512499

Scale: 1:500

Legal: LOT 2

D.L.: 1599

PLAN: ~~X1898~~ EPP9554

Address: EUGENE ROAD 7072 Eugene Rd


Sanitary Connection:#	SIZE: 100mmØ	MATERIAL: PVC	INV. 745.06m	CONNECTED
Water Connection:#	SIZE: 19mmØ	MATERIAL: COPPER	INV. 745.30m	CONNECTED
Storm Connection:#	SIZE: 100mmØ	MATERIAL: PVC	INV. 745.06m	CONNECTED
Cash Receipt No's:	WATER		SANITARY	
			STORM	
CURB FROM PROPERTY LINE	5.0m		PAVEMENT WIDTH	10.0m
HYDRO	75mm BD2	U/G CONNECTION	✓	
TELEPHONE	50mm BD2	U/G CONNECTION	✓	
GAS	42 PROP /P.E			

Information Sheets: L&M ENGINEERING LTD REFERENCE DRAWINGS - 1313-06-04-C001

Comments: CS CURB STOP SDW WATER SERVICE HYDRO SERVICE GAS
CO CLEAN OUT STORM SERVICE CABLE SERVICE
SANITARY SERVICE TELECOMMUNICATIONS ELECTRICAL

THE INFORMATION CONTAINED HEREIN IS FOR INTERNAL USE ONLY.

NOT TO BE RELIED UPON UNLESS CONFIRMED BY THE SITE INSPECTION AND/OR INVESTIGATION

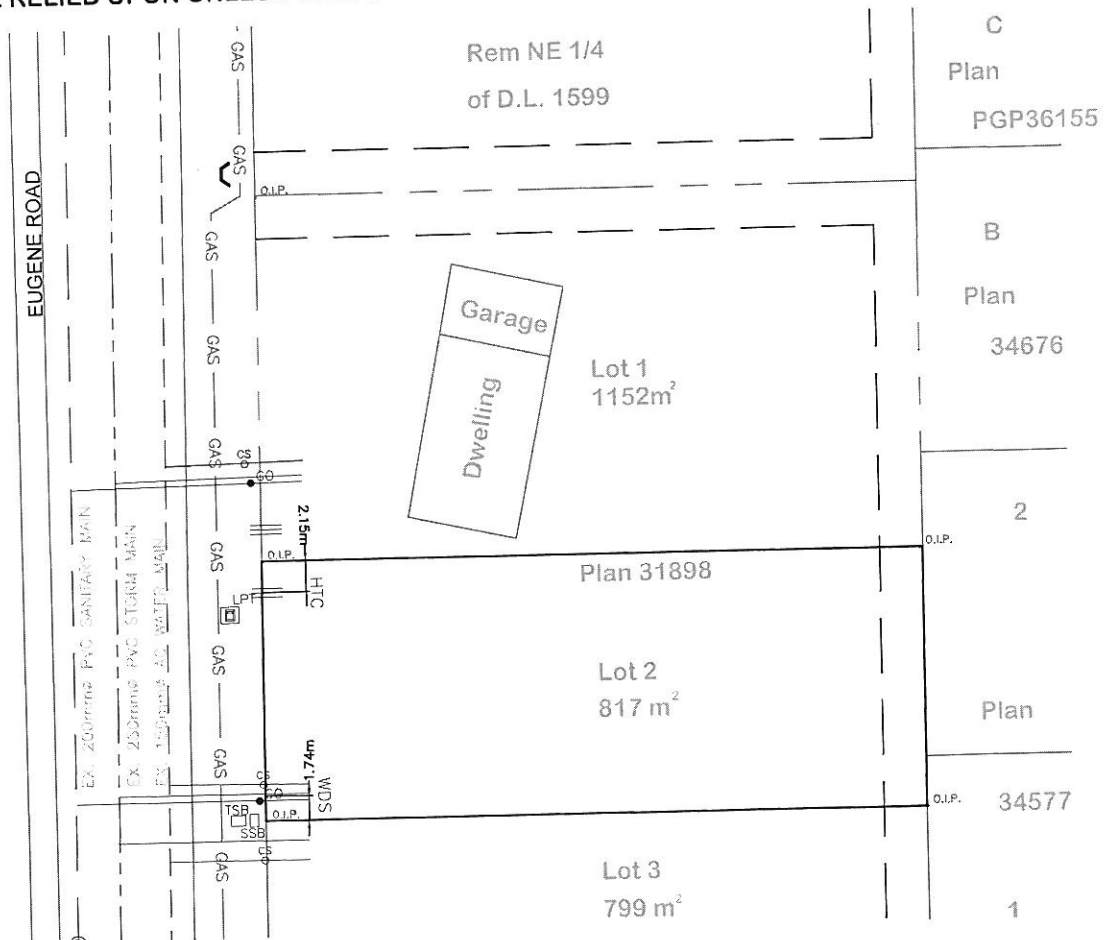

LOT 2

[illegible]

SANITARY HISTORY:

DATE INSTALLED: SEPTEMBER 2010

INSTALLED BY: WESTERN INDUSTRIAL CONTRACTORS

WATER HISTORY:

DATE INSTALLED: SEPTEMBER 2010

INSTALLED BY: WESTERN INDUSTRIAL CONTRACTORS

STORM HISTORY:

DATE INSTALLED: SEPTEMBER 2010

INSTALLED BY: WESTERN INDUSTRIAL CONTRACTORS