

City of Prince George
HISTORY SHEET

PID: 028512502

Scale: 1:500

Legal: LOT 3

D.L.: 1599

PLAN: ~~31898~~ EPP9554

Address: EUGENE ROAD 7098 Eugene Rd CONNECTED

Sanitary Connection:# SIZE: 100mmØ MATERIAL: PVC INV. 745.60m CONNECTED

Water Connection:# SIZE: 19mmØ MATERIAL: COPPER INV. 745.38m

Storm Connection:# SIZE: 100mmØ MATERIAL: PVC INV. 745.97m CONNECTED

Cash Receipt No's: WATER 0758 SANITARY STORM

CURB FROM PROPERTY LINE 5.0m PAVEMENT WIDTH 10.0m

HYDRO 75mm BD2 U/G CONNECTION ✓

TELEPHONE 50mm BD2 U/G CONNECTION ✓


GAS 42 PROP /P.E

Information Sheets: L&M ENGINEERING LTD REFERENCE DRAWINGS - 1313-06-04-C001

Comments: CS CURB STOP SDW WATER SERVICE HYDRO SERVICE GAS GAS
CO CLEAN OUT SDW STORM SERVICE CABLE SERVICE ELECTRICAL
SDW SANITARY SERVICE TELECOMMUNICATIONS

THE INFORMATION CONTAINED HEREIN IS FOR INTERNAL USE ONLY.

NOT TO BE RELIED UPON UNLESS CONFIRMED BY THE SITE INSPECTION AND/OR INVESTIGATION

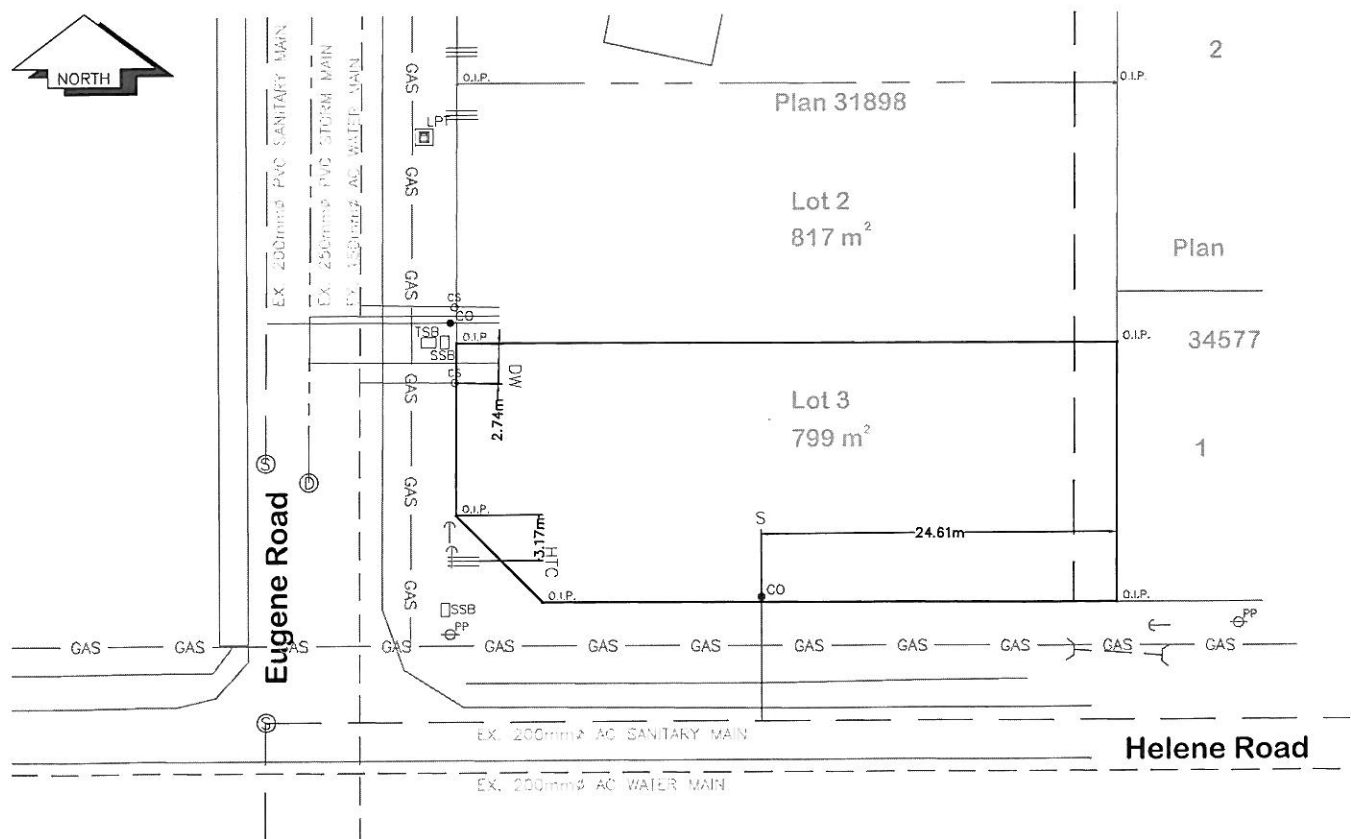

SANITARY, STORM & WATER SERVICE INVERTS	SANITARY	WATER	STORM
1. Distance from San. M.H. 4369 toward San. M.H. 4368 to lot service connection point is:	34.22m	N/A	N/A
1a.Distance from Stm. M.H. 3436 toward Stm. M.H. 3435 to lot service connection point is:	N/A	N/A	8.24m
2. Main Size at connection point is	200mmØ	150mmØ	250mmØ
3. Invert of main at conn. stub point is	745.42m	744.77m	745.50m
4. Invert at service end is	745.66m	745.64m	745.97m
5. Cover at property line in meters	3.20m	2.89m	2.35m
6. Survey DateNOV 2010 Book Ref.: HELENEASBUILTS By: FORESIGHT SURVEY AND DESIGN			

SANITARY HISTORY:

DATE INSTALLED:-

INSTALLED BY:-

WATER HISTORY:

DATE INSTALLED: SEPTEMBER 2010

INSTALLED BY: WESTERN INDUSTRIAL CONTRACTORS

STORM HISTORY:

DATE INSTALLED: SEPTEMBER 2010

INSTALLED BY: WESTERN INDUSTRIAL CONTRACTORS