



# City of Prince George History Sheet

PID:	028610458
MU:	101275
WO:	64789/64790

Civic Address: 625 Vancouver St  
1615/1617 6th Ave

Legal Description: Lot: 1 District Lot: 343 Plan: EPP12869


Service Type	Diameter (mm)	Material	Invert Elev at main (m)	Depth of cut at property line (m)	Invert Elev at service end (m)	Distance into property (m)	Installation Date
Sanitary	100mm	PVC	-	1.72	576.44	-	-
Water	50mm	Copper	-	-	-	-	May 2012
Storm	200mm	PVC	-	-	-	-	may 2012

Service Connection Location				Sanitary (m)	Storm (m)
Distance from downstream San MH	3096	towards upstream San MH	2001	35.80	
Storm service connected to Stm MH 1036					

Power	Size	Communications	Size	Cable	Size	Gas	Size
BC Hydro	-	Telus	-	Shaw	-	FortisBC	-
Overhead Service		Overhead Service		Overhead Service			

Installed by:	City of Prince George forces	Survey Date:	-
Comments:			

**NOT TO SCALE** The information contained herein is for internal use only.  
Not to be relied on unless confirmed by site inspection and/or investigation.

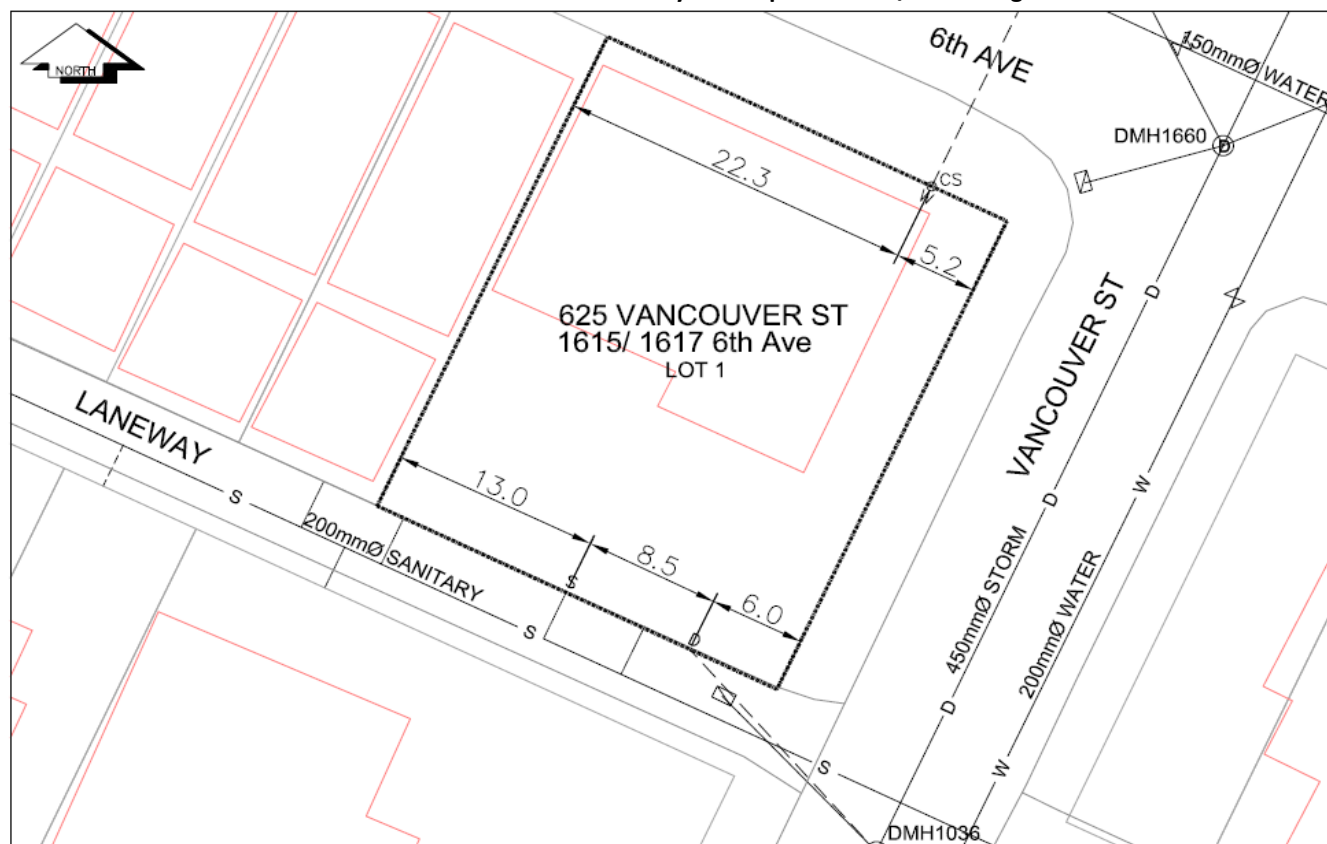

LEGEND:	CS CURB STOP	--- WATER SERVICE	--- STORM SERVICE
	CO CLEAN OUT	--- SANITARY SERVICE	⊗ WATER VALVE

**NOT TO SCALE**