



City of Prince George
History Sheet

PID:	028611012
MU:	101141
WO:	

Civic Address: 550, 562, 582 George St

Legal Description: Lot: A District Lot: 343 Plan: BCP48402


Service Type	Diameter (mm)	Material	Invert Elev at main (m)	Depth of cut at property line (m)	Invert Elev at service end (m)	Distance into property (m)	Installation Date
Sanitary	150mm	PVC	-	-	-	-	January 1960
Water	100mm	PVC	-	-	567.88	-	
Storm	150mm	AC	-	1.33	567.88	-	

Service Connection Location				Sanitary (m)	Storm (m)
Distance from downstream San MH	617	towards upstream San MH	2876	43.30	
Distance from downstream Stm MH	2222	towards upstream Stm MH	2223		17.36

Power	Size	Communications	Size	Cable	Size	Gas	Size
BC Hydro	-	Telus	-	Shaw	-	FortisBC	-
Overhead Service		Overhead Service		Overhead Service			

Installed by:	City of Prince George forces	Survey Date:	-
Comments:			

NOT TO SCALE The information contained herein is for internal use only.
Not to be relied on unless confirmed by site inspection and/or investigation.

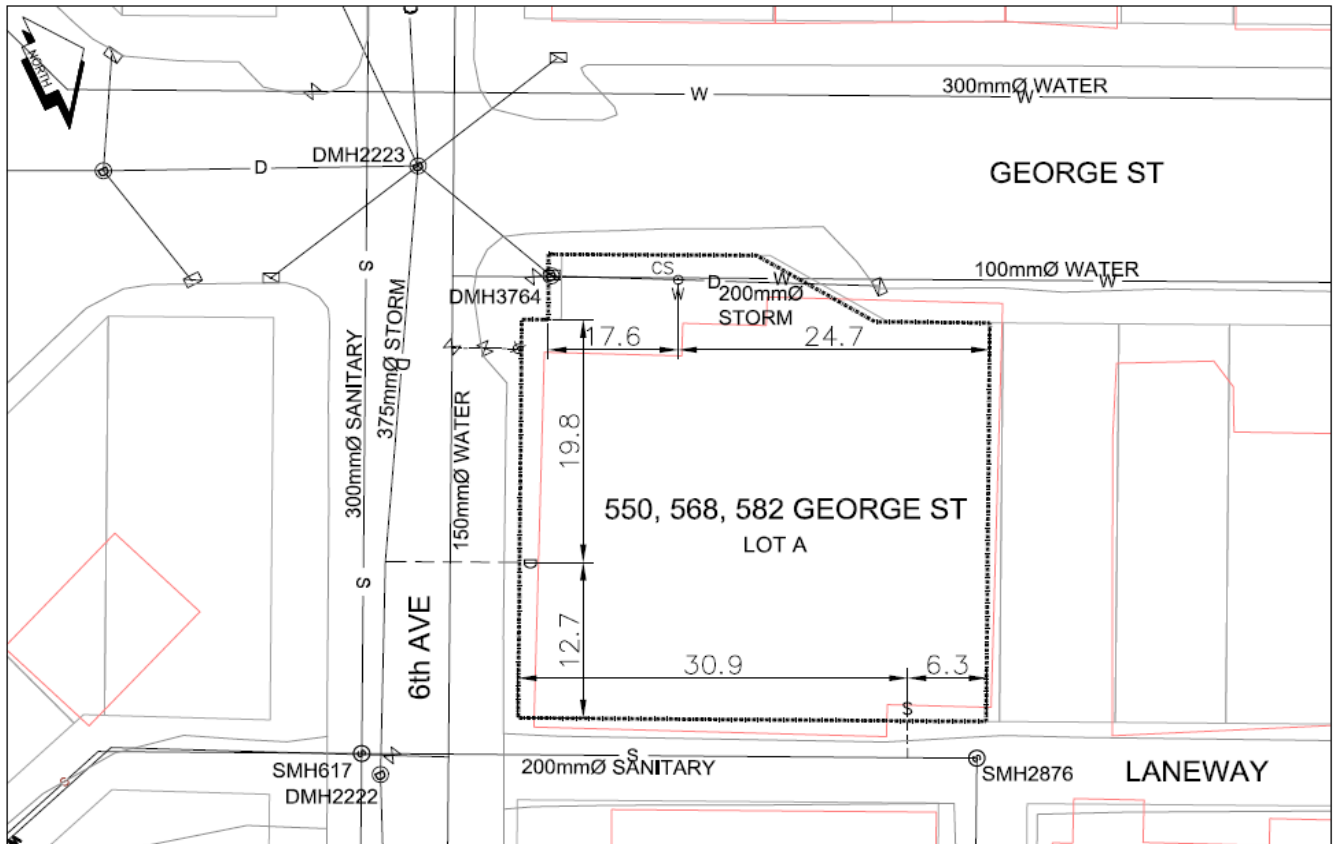

LEGEND:	CS ^o CURB STOP	--- W WATER SERVICE	--- S STORM SERVICE
	CO ^o CLEAN OUT	--- S SANITARY SERVICE	⊗ WATER VALVE

NOT TO SCALE