



# City of Prince George History Sheet

|      |            |
|------|------------|
| PID: | 028635086- |
| MU:  | 100793     |
| WO:  | 36859      |

Civic Address: 4881 Poty Rd

Legal Description: Lot: 1 District Lot: 954 Plan: EPP4946


| Service Type | Diameter (mm) | Material | Invert Elev at main (m) | Invert Elev at property line (m) | Invert Elev at service end (m) | Distance into property (m) | Installation Date |
|--------------|---------------|----------|-------------------------|----------------------------------|--------------------------------|----------------------------|-------------------|
| Sanitary     | 100mm         | PVC      | -                       | -                                | -                              | -                          | -                 |
| Water        | 20mm          | Copper   | -                       | -                                | -                              | -                          | October 2007      |
| Storm        | N/A           | N/A      | -                       | -                                | -                              | -                          | -                 |

| Service Connection Location     |      |                         |      |  | Sanitary (m) | Storm (m) |
|---------------------------------|------|-------------------------|------|--|--------------|-----------|
| Distance from downstream San MH | 1010 | towards upstream San MH | 1011 |  | 102.90       |           |
| Distance from downstream Stm MH | -    | towards upstream Stm MH | -    |  |              |           |

| Power               | Size | Communications      | Size | Cable               | Size | Gas      | Size |
|---------------------|------|---------------------|------|---------------------|------|----------|------|
| BC Hydro            | -    | Telus               | -    | Shaw                | -    | FortisBC | -    |
| Underground Service |      | Underground Service |      | Underground Service |      |          |      |

|               |  |              |   |
|---------------|--|--------------|---|
| Installed by: | City of Prince George forces   | Survey Date: | - |
| Comments:     | Utility locations confirmed 2011-08-11 (WO 60441). Valve on 4881 Poty Rd shuts off 20mm service to 4855 Poty Rd (Lot 2). |              |   |

**NOT TO SCALE The information contained herein is for internal use only.  
Not to be relied on unless confirmed by site inspection and/or investigation.**

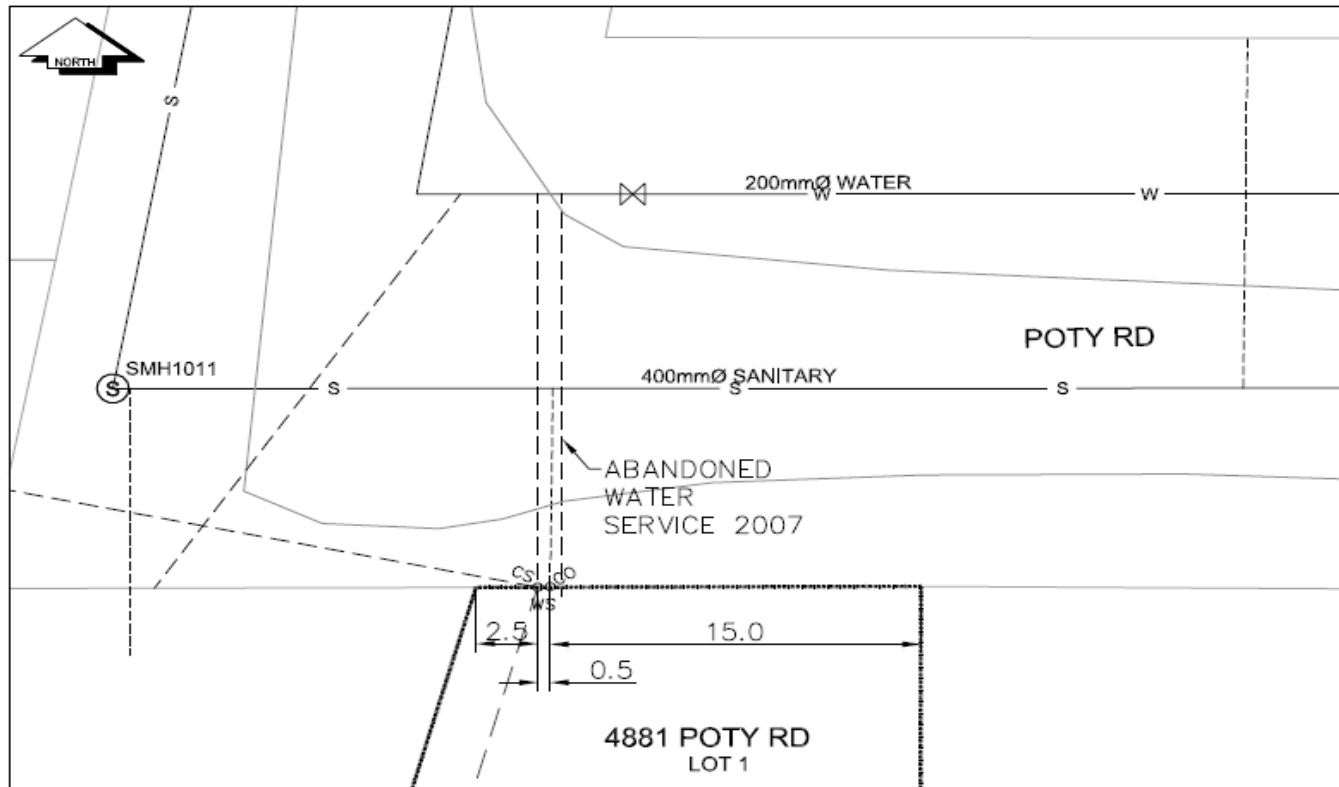

|         |                           |                      |                   |
|---------|---------------------------|----------------------|-------------------|
| LEGEND: | CS <sup>o</sup> CURB STOP | --- WATER SERVICE    | --- STORM SERVICE |
|         | CO <sup>o</sup> CLEAN OUT | --- SANITARY SERVICE | ⊗ WATER VALVE     |

NOT TO SCALE