



# City of Prince George History Sheet

PID:	028635108
MU:	100793
WO:	36858

Civic Address: 4855 Poly Rd

Legal Description: Lot: 2 District Lot: 954 Plan: EPP4946


Service Type	Diameter (mm)	Material	Invert Elev at main (m)	Invert Elev at property line (m)	Invert Elev at service end (m)	Distance into property (m)	Installation Date
Sanitary	100mm	PVC	-	-	-	3.00	-
Water	20mm	Copper	-	-	-	2.71	-
Water	50mm	Copper	-	-	-	-	October 2007
Storm	N/A	N/A	-	-	-	-	-

Service Connection Location				Sanitary (m)	Storm (m)
Distance from downstream San MH	1010	towards upstream San MH	1011	120.00	-
Distance from downstream Stm MH	-	towards upstream Stm MH	-	-	-

Power	Size	Communications	Size	Cable	Size	Gas	Size
BC Hydro	-	Telus	-	Shaw	-	FortisBC	-
Underground Service		Underground Service		Underground Service			

Installed by:	City of Prince George forces	Survey Date:	-
Comments:	Abandoned water service - 2007		

**NOT TO SCALE** The information contained herein is for internal use only.  
Not to be relied on unless confirmed by site inspection and/or investigation.

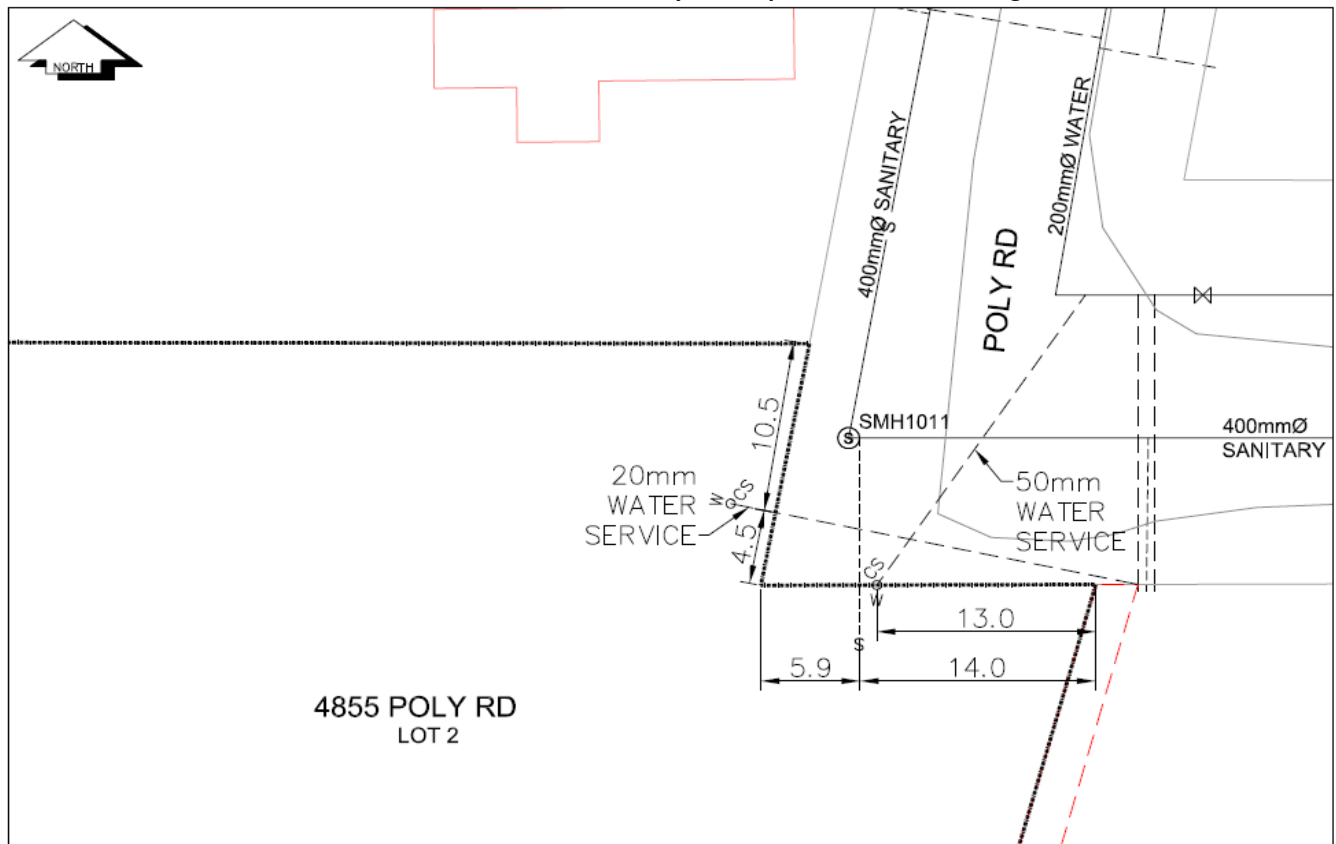

LEGEND:	CS <sup>o</sup> CURB STOP	— — — — — WATER SERVICE	— — — — — STORM SERVICE
	CO <sup>o</sup> CLEAN OUT	— — — — — SANITARY SERVICE	⊗ WATER VALVE

**NOT TO SCALE**