



City of Prince George
History Sheet

PID:	028667735
SD/MU:	
WO:	

Civic Address: 1643 4th Ave

Legal Description: Lot: 1 District Lot: 343 Plan: EPP14971


Service Type	Diameter (mm)	Material	Invert Elev at main (m)	Depth of cut at property line (m)	Invert Elev at service end (m)	Distance into property (m)	Installation Date
Sanitary	100mm	PVC	-	2.15	575.73	-	June 1958
Water	20mm	Copper	-	-	-	-	
Storm	N/A	N/A	-	-	-	-	

Service Connection Location					Sanitary (m)	Storm (m)
Distance from downstream San MH	1997	towards upstream San MH	1995		47.30	
Distance from downstream Stm MH	-	towards upstream Stm MH	-		-	

Power	Size	Communications	Size	Cable	Size	Gas	Size
BC Hydro	-	Telus	-	Shaw	-	FortisBC	-
Overhead Service		Overhead Service		Overhead Service			

Installed by:	Survey Date:	-
Comments:		

NOT TO SCALE The information contained herein is for internal use only.
Not to be relied on unless confirmed by site inspection and/or investigation.

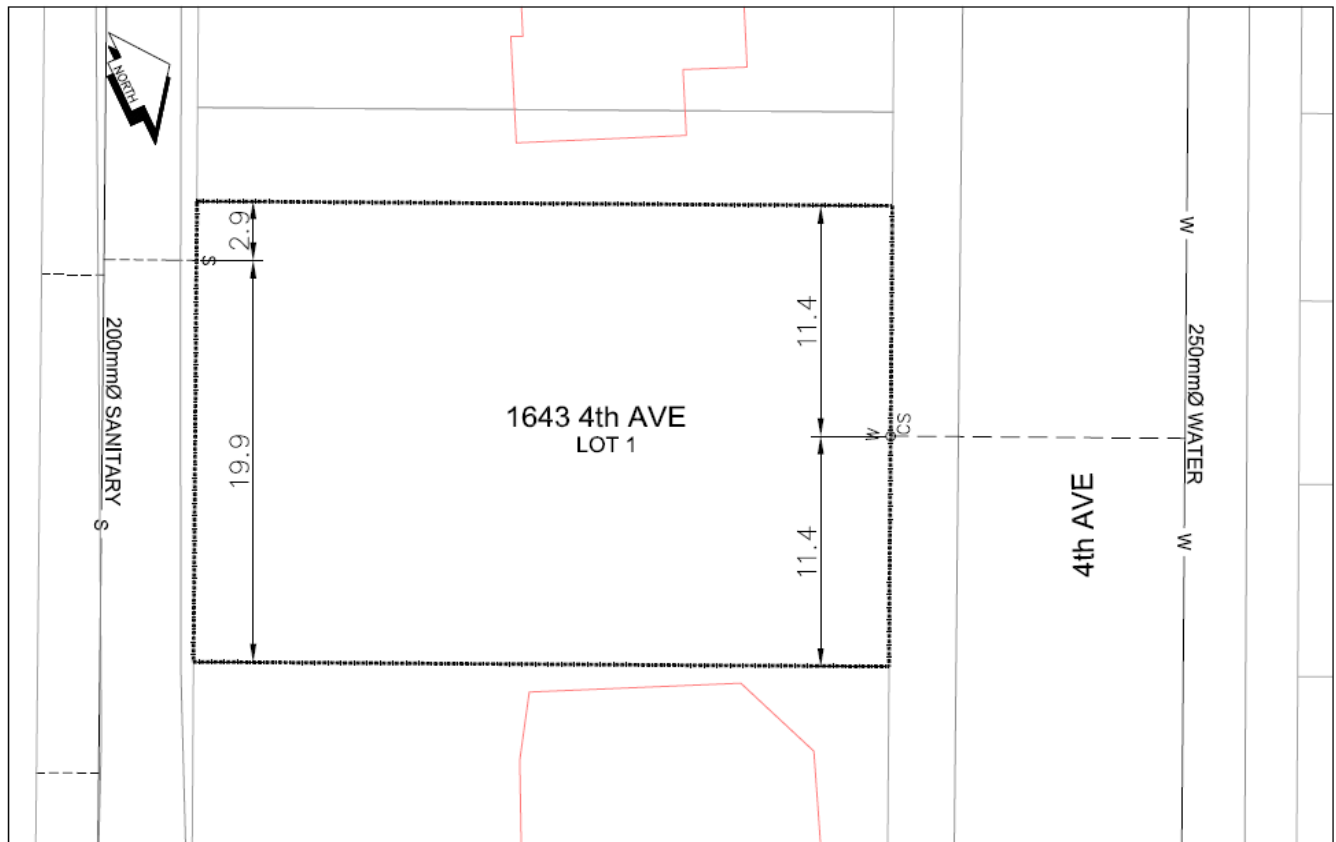

LEGEND:	CS ^o CURB STOP	— — — — — WATER SERVICE	— — — — — STORM SERVICE
	CO ^o CLEAN OUT	— — — — — SANITARY SERVICE	⊗ WATER VALVE

NOT TO SCALE