



City of Prince George History Sheet

PID:	028672500
SD/MU:	101278
WO:	65206

Civic Address: 2614 Petersen Rd

Legal Description: Lot: PCL District Lot: 753 Plan: 8391 Parcel B (Being a consolidation of Lots 21 and 22, see CA2181592)


Service Type	Diameter (mm)	Material	Invert Elev at main (m)	Invert Elev at property line (m)	Invert Elev at service end (m)	Distance into property (m)	Installation Date
Sanitary	100mm	PVC	-	-	-	-	
Water	40mm	Copper	-	-	-	-	June 2012
Storm	200mm	PVC	584.33	584.49	584.55	2.26	June 2012

Service Connection Location						Sanitary (m)	Storm (m)
Distance from downstream San MH			-	towards upstream San MH	-	-	
Distance from downstream Stm MH			-	towards upstream Stm MH	-		

Power	Size	Communications	Size	Cable	Size	Gas	Size
BC Hydro	-	Telus	-	Shaw	-	FortisBC	-
Overhead Service		Overhead Service		Overhead Service			

Installed by:	City of Prince George forces	Survey Date:	August 2014
Comments:			

NOT TO SCALE The information contained herein is for internal use only.
Not to be relied on unless confirmed by site inspection and/or investigation.

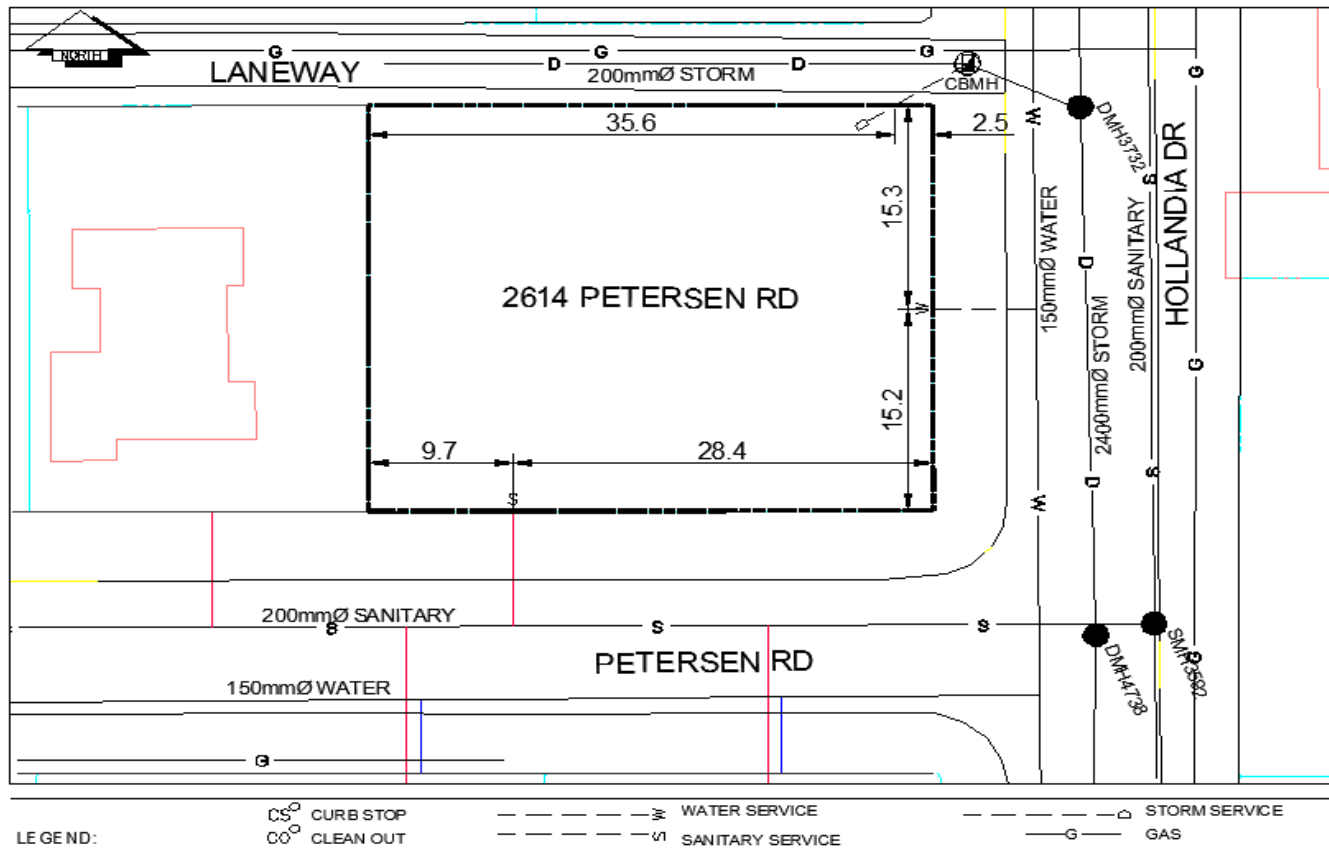

NOT TO SCALE