



City of Prince George
History Sheet

PID:	028675410
MU:	101664 101229
WO:	60948/60949

Civic Address: 811 Foreman Rd

Legal Description: Lot: 2 District Lot: 954 Plan: EPP13900


Service Type	Diameter (mm)	Material	Invert Elev at main (m)	Invert Elev at property line (m)	Invert Elev at service end (m)	Distance into property (m)	Installation Date
Sanitary	100mm	PVC	-	-	-	6.00	May 2012
Water	20mm	Copper	-	-	-	6.00	May 2012
Storm	N/A	N/A	-	-	-	-	

Service Connection Location	Sanitary (m)	Storm (m)
Sanitary service connected to San MH 1665	-	
Distance from downstream Stm MH - towards upstream Stm MH -		

Power	Size	Communications	Size	Cable	Size	Gas	Size
BC Hydro	-	Telus	-	Shaw	-	FortisBC	-
Overhead Service		Overhead Service		Overhead Service			

Installed by: City of Prince George forces	Survey Date:	-
Comments:		

NOT TO SCALE The information contained herein is for internal use only.
Not to be relied on unless confirmed by site inspection and/or investigation.

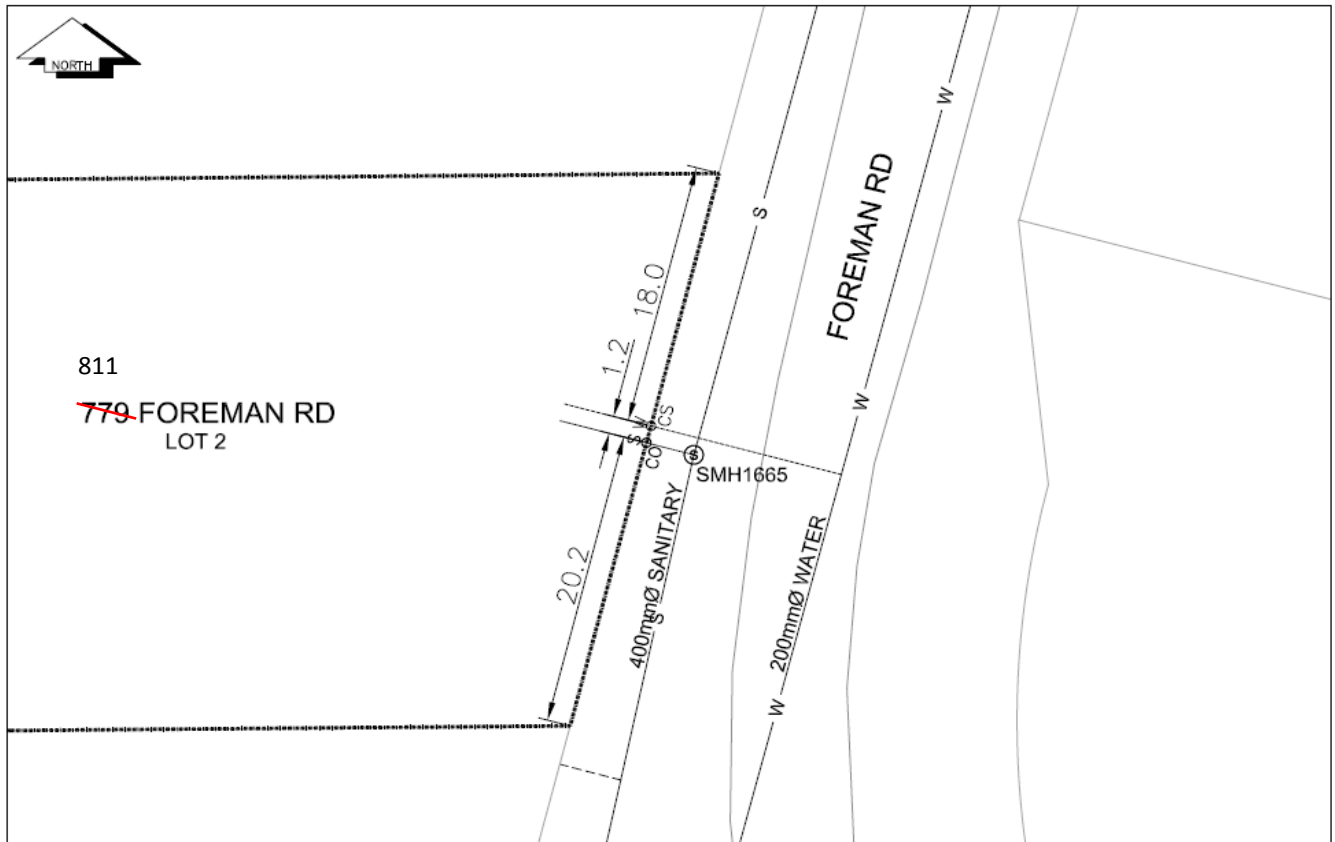

LEGEND:	CS CURB STOP	--- W WATER SERVICE	--- S SANITARY SERVICE	--- D STORM SERVICE	⊗ WATER VALVE
	CO CLEAN OUT				

NOT TO SCALE