



# City of Prince George History Sheet

PID:	028675428
MU:	101664
WO:	89586/89659

Civic Address: 847 Foreman Rd

Legal Description: Lot: 3 District Lot: 954 Plan: EPP13900


Service Type	Diameter (mm)	Material	Invert Elev at main (m)	Invert Elev at property line (m)	Invert Elev at service end (m)	Distance into property (m)	Installation Date
Sanitary	100mm	PVC	664.71	664.82	664.82	-	October 2016
Water	40mm	Copper	666.25	665.64	665.64	-	October 2016
Storm	N/A	N/A	-	-	-	-	

Service Connection Location				Sanitary (m)	Storm (m)
Distance from downstream San MH	1664	towards upstream San MH	1665	4.00	
Distance from downstream Stm MH	-	towards upstream Stm MH	-		

Power	Size	Communications	Size	Cable	Size	Gas	Size
BC Hydro	-	Telus	-	Shaw	-	FortisBC	-
Overhead Service		Overhead Service		Overhead Service			

Installed by:	City of Prince George forces	Survey Date:	-
Comments:			

**NOT TO SCALE** The information contained herein is for internal use only.  
Not to be relied on unless confirmed by site inspection and/or investigation.

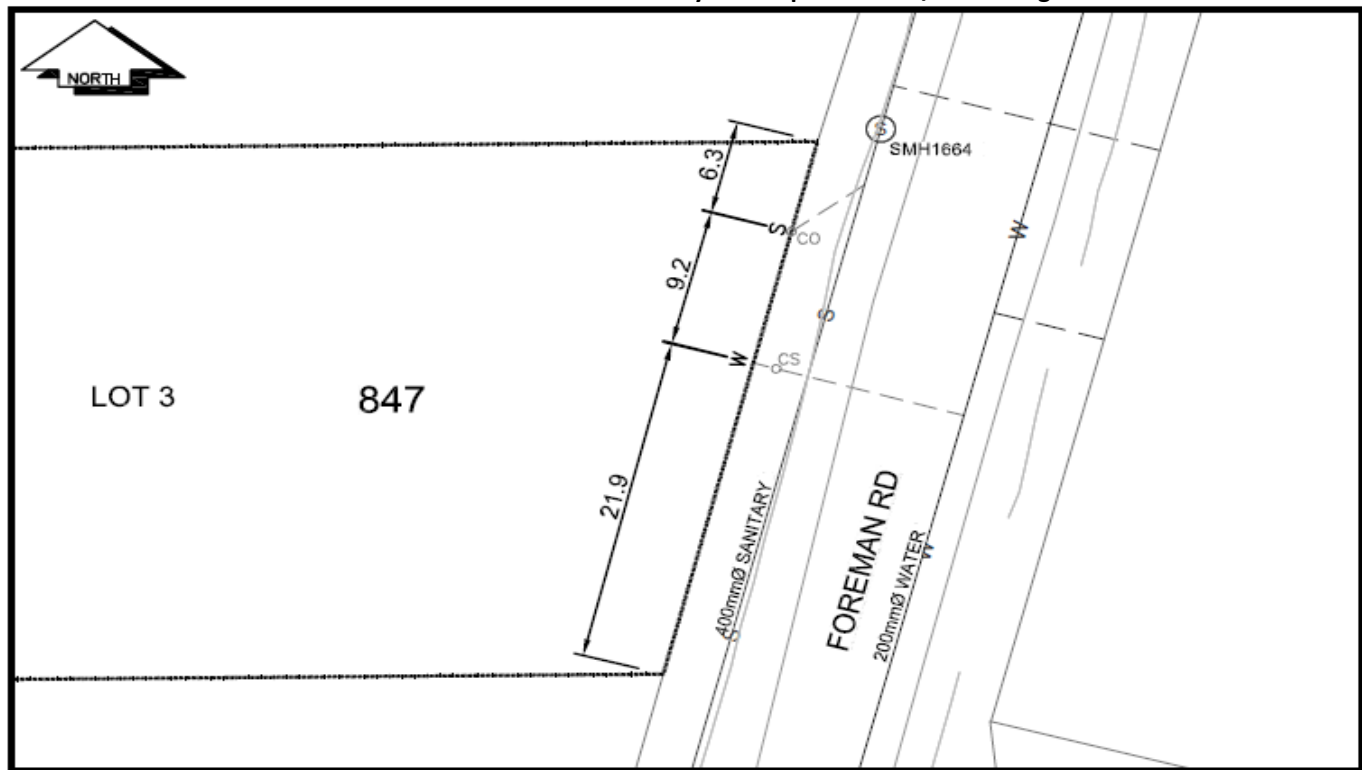

CS <sup>o</sup> CURB STOP	--- W WATER SERVICE	--- O STORM SERVICE
CO <sup>o</sup> CLEAN OUT	--- S SANITARY SERVICE	--- G GAS
WV WATER VALVE	--- FH FIRE HYDRANT	--- ENCUMBRANCE

**NOT TO SCALE**