



# City of Prince George History Sheet

PID:	028677374
SD:	100340
WO:	

Civic Address: 6855 O'Grady Rd

Legal Description: Lot: 2 District Lot: 2003 Plan: EPP12463


Service Type	Diameter (mm)	Material	Invert Elev at main (m)	Depth of cut at property line (m)	Invert Elev at service end (m)	Distance into property (m)	Installation Date
Sanitary	100mm	PVC	-	2.14	65260.00	-	November 1993
Water	20mm	Copper	-	-	-	-	November 1993
Storm	100mm	PVC	-	2.31	652.60	-	November 1993

Service Connection Location				Sanitary (m)	Storm (m)
Distance from downstream San MH	4193	towards upstream San MH	4195	67.05	
Distance from downstream Stm MH	518	towards upstream Stm MH	519		81.00

Power	Size	Communications	Size	Cable	Size	Gas	Size
BC Hydro	-	Telus	-	Shaw	-	FortisBC	-
Underground Service		Underground Service		Underground Service			

Installed by:	Survey Date:	-
Comments:		

**NOT TO SCALE** The information contained herein is for internal use only.  
Not to be relied on unless confirmed by site inspection and/or investigation.

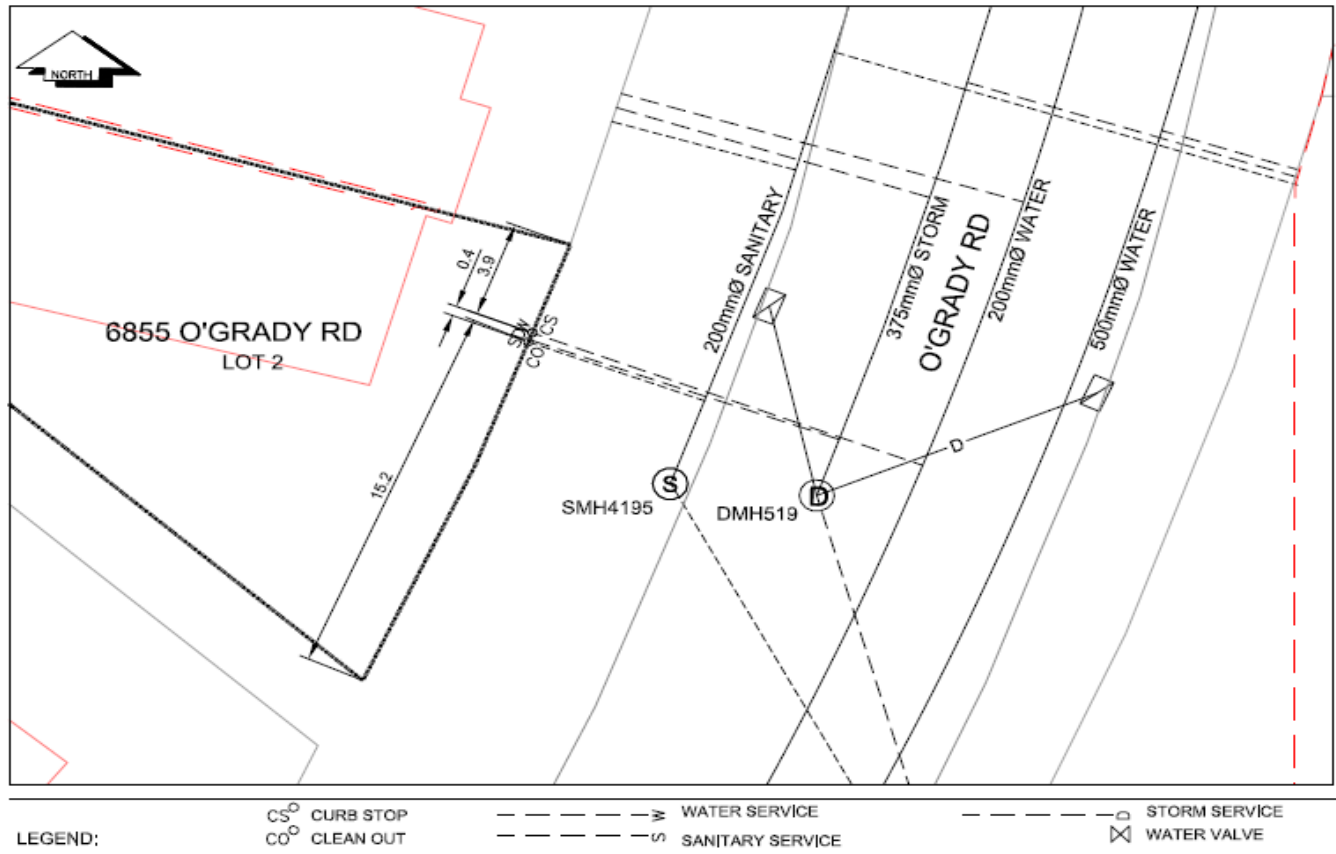

**NOT TO SCALE**