



# City of Prince George History Sheet

PID:	028682815
SD/MU:	100325/100844
WO:	42612/42613

Civic Address: 747 Winnipeg St

Legal Description: Lot: 2 District Lot: 343 Plan: BCP49159


Service Type	Diameter (mm)	Material	Invert Elev at main (m)	Invert Elev at property line (m)	Invert Elev at service end (m)	Distance into property (m)	Installation Date
Sanitary	300mm	AC	-	-	-	-	January 1980
Water 6th Ave	200mm	PVC	-	-	-	-	August 2008
Storm	N/A	N/A	-	-	-	-	January 1972

Service Connection Location	Sanitary (m)	Storm (m)
300mm sanitary service connected to San MH 3084	-	
Distance from downstream Stm MH towards upstream Stm MH		

Power	Size	Communications	Size	Cable	Size	Gas	Size
BC Hydro	-	Telus	-	Shaw	-	FortisBC	-
Underground Service		Underground Service		Underground Service			

Installed by:	Survey Date:	-
Comments: Storm flow managed by onsite recharge chambers		

**NOT TO SCALE** The information contained herein is for internal use only.  
Not to be relied on unless confirmed by site inspection and/or investigation.

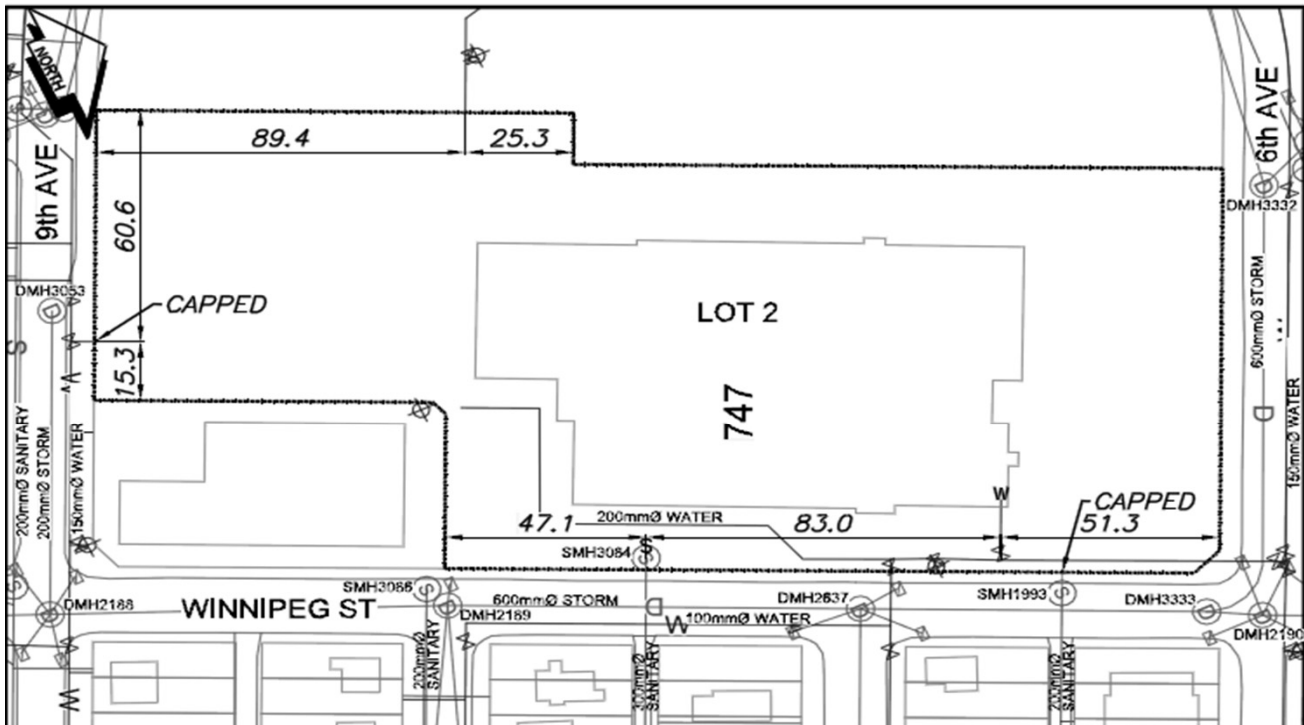

CS CURB STOP	W WATER SERVICE	STORM SERVICE
CO CLEAN OUT	S SANITARY SERVICE	G GAS
WV WATER VALVE	FH FIRE HYDRANT	ENCUMBRANCE

**NOT TO SCALE**