



# City of Prince George History Sheet

PID:	028682823
SD	100325
WO:	

Civic Address: 2435 Ross Cres

Legal Description: Lot: 3 District Lot: 343 Plan: BCP49159


Service Type	Diameter (mm)	Material	Invert Elev at main (m)	Depth of cut at property line (m)	Invert Elev at service end (m)	Distance into property (m)	Installation Date
Sanitary - S1	100mm	PVC	-	2.26	581.46	-	June 1958
Sanitary - S2	100mm	PVC	-	-	-	-	2014
Water - W1	20mm	Copper	-	-	-	-	May 1958
Water - W2	50mm	Copper	-	-	-	-	2014
Storm	N/A	N/A	-	-	-	-	

Service Connection Location				Sanitary (m)	Storm (m)
Distance from downstream San MH	1067	towards upstream San MH	3085	66.99	
New 100mm Sanitary service connected to San MH 1994					

Power	Size	Communications	Size	Cable	Size	Gas	Size
BC Hydro	-	Telus	-	Shaw	-	FortisBC	-
Underground Service		Underground Service		Underground Service			

Installed by:		Survey Date:	-
Comments:	Service confirmed by dye test - July 2014		

**NOT TO SCALE** The information contained herein is for internal use only.  
Not to be relied on unless confirmed by site inspection and/or investigation.

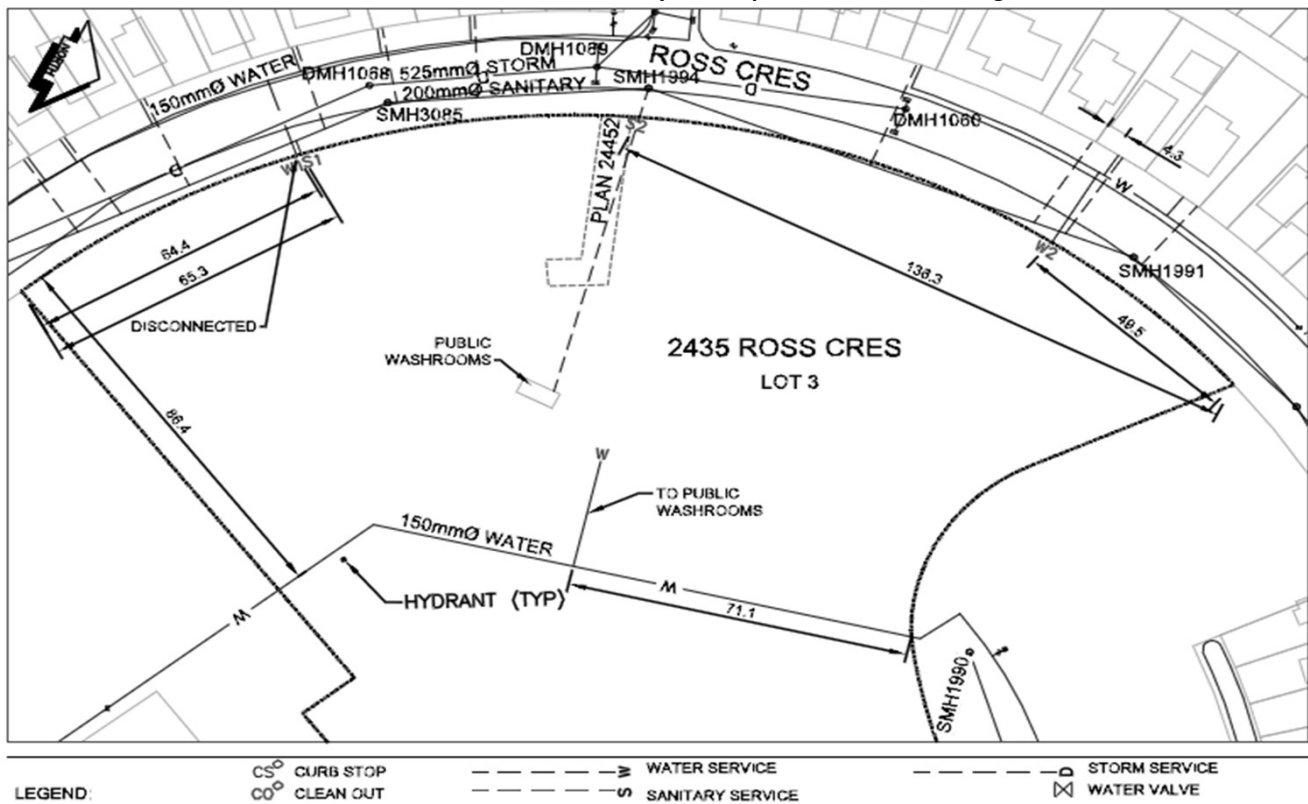

**NOT TO SCALE**