



City of Prince George
History Sheet

PID:	028708008
MU:	100819
WO:	39766

Civic Address: 7010 Westmount Dr

Legal Description: Lot: A District Lot: 1605 Plan: EPP12279


Service Type	Diameter (mm)	Material	Invert Elev at main (m)	Invert Elev at property line (m)	Invert Elev at service end (m)	Distance into property (m)	Installation Date
Sanitary	100mm	PVC	-	-	745.31	-	-
Water	20mm	Copper	-	-	745.30	-	-
Storm	100mm	PVC	-	-	745.32	-	-

Service Connection Location	Sanitary (m)	Storm (m)
Sanitary service connected to San MH 4988	-	-
Storm service connected to Stm MH 3491	-	-

Power	Size	Communications	Size	Cable	Size	Gas	Size
BC Hydro	75mm	Telus	50mm	Shaw	-	FortisBC	42 PROP/P.E.
Underground Service		Underground Service		Underground Service			

Installed by:	City of Prince George forces	Survey Date:	-
Comments:			

NOT TO SCALE The information contained herein is for internal use only.
Not to be relied on unless confirmed by site inspection and/or investigation.

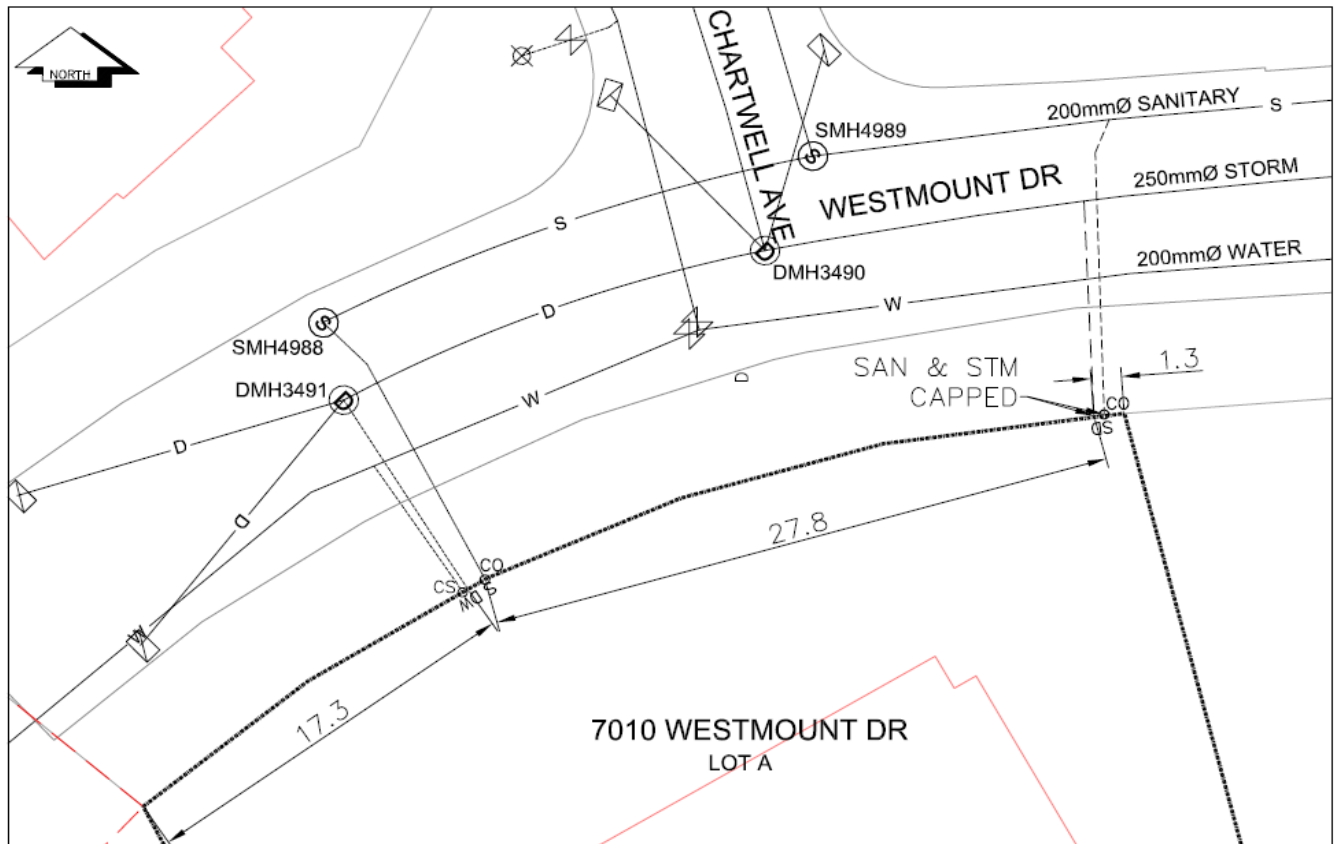

LEGEND:	CS ^o CURB STOP	--- WATER SERVICE	--- STORM SERVICE
	CO ^o CLEAN OUT	--- SANITARY SERVICE	⊗ WATER VALVE

NOT TO SCALE