

Legal Description: Lot: B District Lot: 1605 Plan: EPP12279


Service Type	Diameter (mm)	Material	Invert Elev at main (m)	Invert Elev at property line (m)	Invert Elev at service end (m)	Distance into property (m)	Installation Date
Sanitary	100mm	PVC	-	745.19	-	-	-
Water	20mm	Copper	-	745.20	-	-	-
Storm	100mm	PVC	-	745.23	-	-	-

Service Connection Location				Sanitary (m)	Storm (m)
Distance from downstream San MH	4989	towards upstream San MH	4990	63.99	
Distance from downstream Stm MH	3490	towards upstream Stm MH	3488		61.83

<b>Power</b>	<b>Size</b>	<b>Communications</b>	<b>Size</b>	<b>Cable</b>	<b>Size</b>	<b>Gas</b>	<b>Size</b>
BC Hydro	75mm	Telus	50mm	Shaw	-	FortisBC	42 PROP/P.E.
Underground Service		Underground Service		Underground Service			

Installed by:	Survey Date:	-
Comments:		

**NOT TO SCALE** The information contained herein is for internal use only.  
Not to be relied on unless confirmed by site inspection and/or investigation.

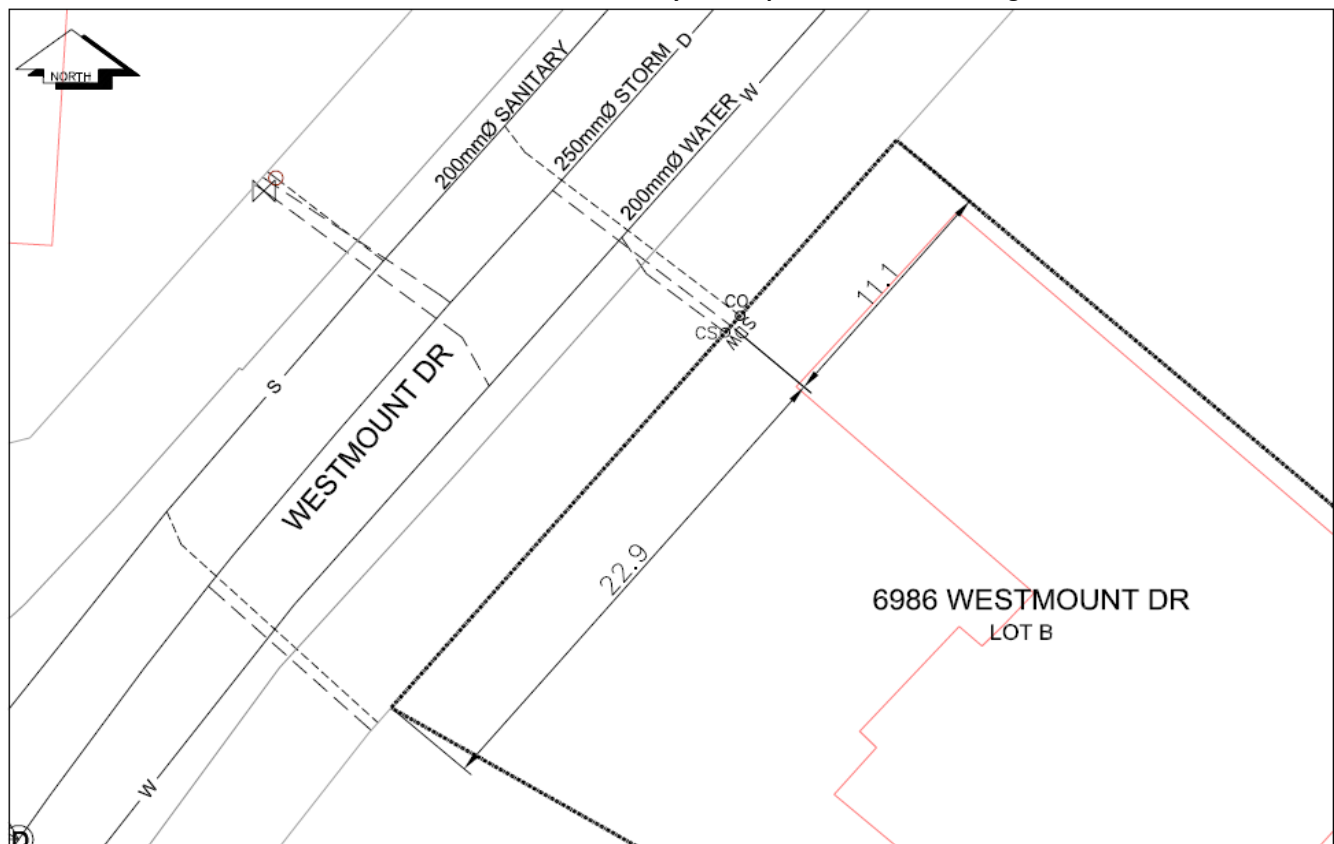

LEGEND:	CS <sup>o</sup>	CURB STOP	— — — — — W	WATER SERVICE	— — — — — D	STORM SERVICE
	CO <sup>o</sup>	CLEAN OUT	— — — — — S	SANITARY SERVICE	⊗	WATER VALVE

**NOT TO SCALE**