



# City of Prince George History Sheet

PID:	028709497
SD/MU:	
WO:	

Civic Address: 443 Kelly St

Legal Description: Lot: A District Lot: 937 Plan: EPP15400


Service Type	Diameter (mm)	Material	Invert Elev at main (m)	Depth of cut at property line (m)	Invert Elev at service end (m)	Distance into property (m)	Installation Date
Sanitary	100mm	PVC	-	2.06	599.31	-	November 1962
Water	40mm	Copper	-	-	-	-	January 1978
Storm	200mm	PVC	-	2.73	598.64	-	January 1962

Service Connection Location					Sanitary (m)	Storm (m)
Distance from downstream San MH	960	towards upstream San MH	2588		71.90	
Distance from downstream San MH	960	towards upstream Stm MH	203			22.80

Power	Size	Communications	Size	Cable	Size	Gas	Size
BC Hydro	-	Telus	-	Shaw	-	FortisBC	-
Overhead Service		Overhead Service		Overhead Service			

Installed by:	Survey Date:	-
Comments: Water service location confirmed October 2016.		

**NOT TO SCALE** The information contained herein is for internal use only.  
Not to be relied on unless confirmed by site inspection and/or investigation.

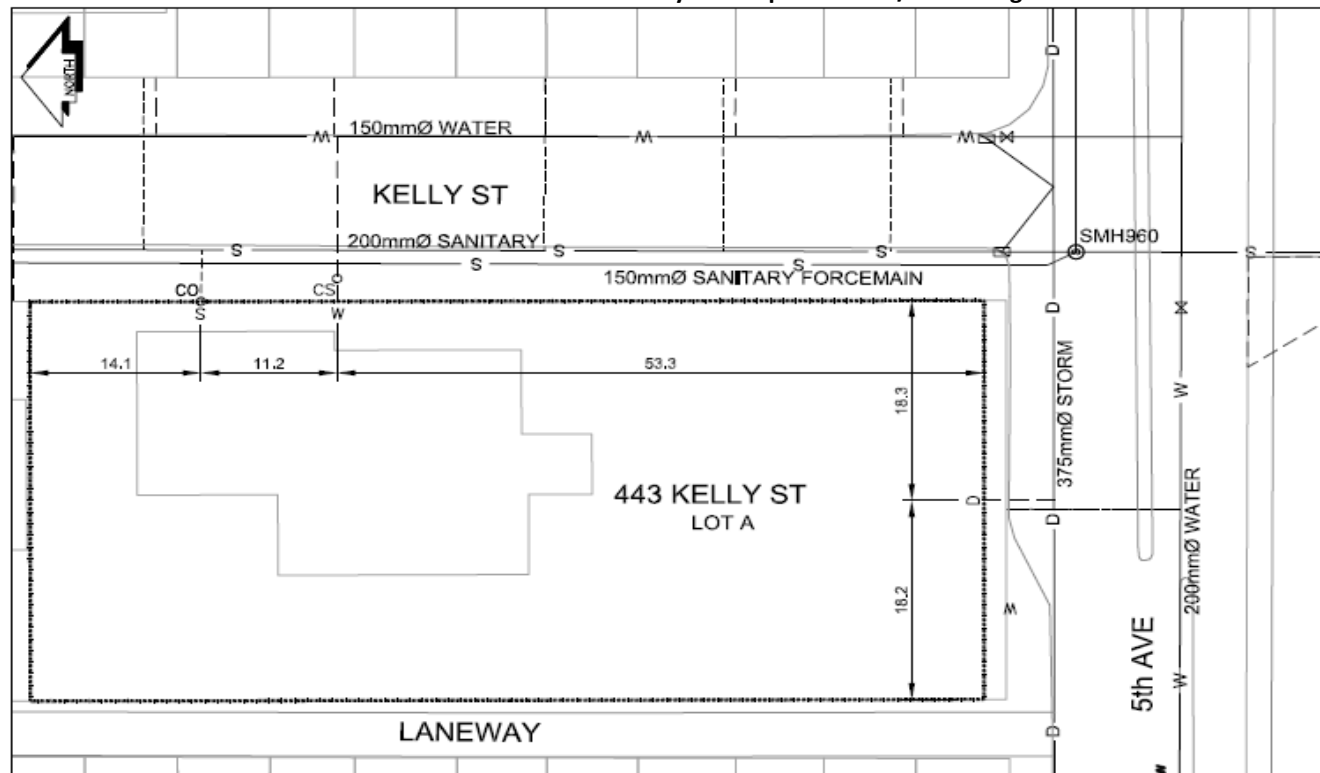

LEGEND:	CS <sup>o</sup> CURB STOP	--- -- -- -- -- WATER SERVICE	--- -- -- -- -- STORM SERVICE
	CO <sup>o</sup> CLEAN OUT	--- -- -- -- -- SANITARY SERVICE	⊗ WATER VALVE

**NOT TO SCALE**