
City of Prince George HISTORY SHEET

PID: 028735251						Scale	: 1:1000)		
Legal: LOT 1					ales	D.L.:	2432		PLAN:	EPP15809
Address: 9271 HOLDN	ER ROAD									
Sanitary Connection:#		SIZE:	100mmØ	MATERIAL:	PVC		INV.	737.99	CONNE	ECTED
Water Connection:#		SIZE:	19mmØ	MATERIAL:	copper		INV.	737.97	METER	
Storm Connection:#		SIZE	N/A	MATERIAL	N/A		INV.	N/A	N/A	
ash Receipt No's:		WATER SANITA		RY		STORM				
CURB FROM PROPERTY LINE N/A								PAVEMENT WIDTH 8m		
B.C. HYDRO	Overhead									
B.C. TELEPHONE	Overhead	***								
TERASEN	42 PROP/P	.E								
nformation Sheets:	REFERENCE DRAWINGS L&M ENGINEERING LIMITED JOB NO. 1256-07-04									
	CS_ CL	JRB STOP		WATER SERVICE STORM SERVICE		I	HYDRO	SERVICE SERVICE DMMUNICASTIC	— cat — cat —	GAS

THE INFORMATION CONTAINED HEREIN IS FOR INTERNAL USE ONLY.

NOT TO BE RELIED UPON UNLESS CONFIRMED BY THE SITE INSPECTION AND/OR INVESTIGATION

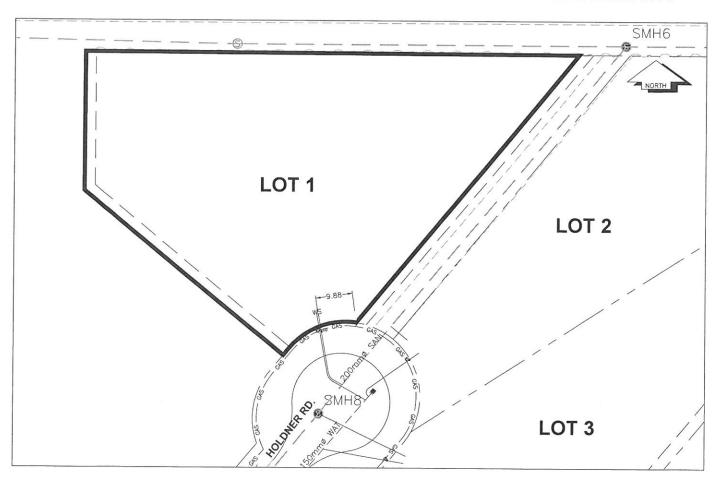

SANITARY, STORM & WATER SERVICE INVERTS	SANITARY	WATER	STORM
1. Distance from San. M.H. 8 toward San. M.H. 6 to lot service connection point is:	11m	N/A	N/A
1a.Distance from Stm. M.H toward Stm. M.H to lot service connection point is:	N/A	N/A	N/A
2. Main Size at connection point is	200mm	150mm	N/A
3. Invert of main at conn. stub point is	737.39	737.98	N/A
4. Invert at service end is	737.99	737.97	N/A
5. Cut at property line in meters	2.50	2.61	N/A
6. Survey Date: AUG. 2012 Book Ref.: 1256-07-04 By: L&M ENGINEERING LTD.			
	3. 00/8/0		1,00 5,00 5,00 1,000
SANITARY HISTORY:			
Installed By: Fair Value Homes Ltd.	,,,,,,,,,,,,,,,,,,,,,,,,,,,,,,,,,,,,,,,	197-14-34-3	
		Service Vision Washington	
	H		
WATER HISTORY:			
Installed By: Fair Value Homes Ltd.			
installed by Fall Value notites Ltd.			
			1999-19
		33110 110000	
		3 300 33	
STORM HISTORY:			
N/A			
	1000-1000-10-00-100		
	***	TRANSPORTED TO THE TRANSPORTED T	