
## City of Prince George HISTORY SHEET

PID: 028735277	3735277					Scale: 1:1250				
Legal: LOT 3				- 40		D.L.:	2432		PLAN:	EPP15809
Address: 9272 HOLDN	ER ROAD									
Sanitary Connection:#	***	SIZE:	100mmØ	MATERIAL:	PVC		INV.	738.43	CONNE	CTED
Water Connection:#		SIZE:	19mmØ	MATERIAL:	copper		INV.	738.30	METER	
Storm Connection:#		SIZE	N/A	MATERIAL	N/A		INV.	N/A	N/A	
Cash Receipt No's:			WATER		SANITA	RY		STORM		
CURB FROM PROPER	URB FROM PROPERTY LINE N/A PAVEMENT WIDTH 8m						8m			
B.C. HYDRO	Overhead									
B.C. TELEPHONE	Overhead									
TERASEN	42 PROP/P.E.		and the section of th				-			
Information Sheets:	REFERENCE DRAWINGS L&M ENGINEERING LIMITED JOB NO. 1256-07-04									
Comments:	CS CURB	STOP N OUT	S	WATER SERVICE STORM SERVICE SANITARY SERV	CE	===	HYDRO CABLE TELECO	SERVICE SERVICE DMMUNICASTI	cas cas	

THE INFORMATION CONTAINED HEREIN IS FOR INTERNAL USE ONLY.

NOT TO BE RELIED UPON UNLESS CONFIRMED BY THE SITE INSPECTION AND/OR INVESTIGATION

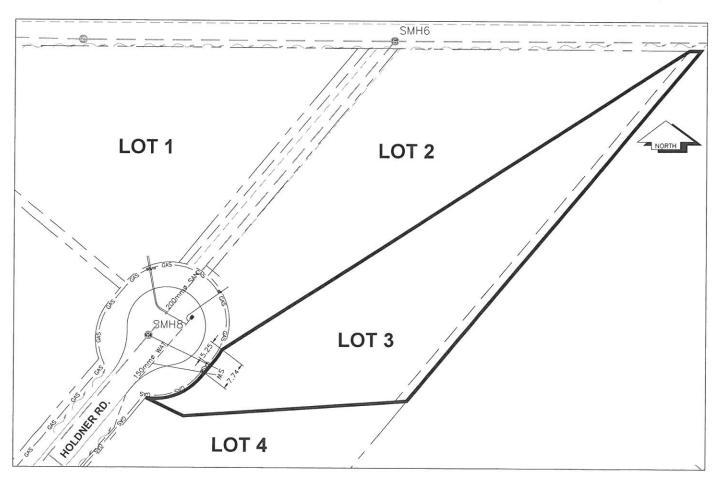

Lot 3

SANITARY, STORM & WATER SERVICE INVERTS	SANITARY	WATER	STORM
1. Distance from San. M.H. 8 toward San. M.H. 6 to lot service connection point is:	0m	N/A	N/A
1a.Distance from Stm. M.H toward Stm. M.H to lot service connection point is:	N/A	N/A	N/A
2. Main Size at connection point is	200mm	150mm	N/A
3. Invert of main at conn. stub point is	737.71	738.20	N/A
4. Invert at service end is	738.43	738.30	N/A
5. Cut at property line in meters	2.34	2.50	N/A
6. Survey Date: AUG. 2012 Book Ref.: 1256-07-04 By: L&M ENGINEERING LTD.		35.401	
SANITARY HISTORY:			
Installed By: Fair Value Homes Ltd.			
			1999
WATER HISTORY:			
Installed By: Fair Value Homes Ltd.			
mounted by Fall Value Hornes Etc.			***
		#	
STORM HISTORY:			
N/A			
	10/800m		
		A	
		1977 B	
	0 100		