
City of Prince George HISTORY SHEET

PID: 028735285						Scale:	1:1000)	- S		
Legal: LOT 4						D.L.: :	2432		PLAN:	EPP15809	
Address: 9256 HOLDN	ER ROAD										
Sanitary Connection:#		SIZE:	100mmØ	MATERIAL:	PVC	1	NV.	740.47	CONNE	ECTED	
Water Connection:#		SIZE:	19mmØ	MATERIAL:	copper	11	NV.	740.03	METER		
Storm Connection:#		SIZE	N/A	MATERIAL	N/A		NV.	N/A	N/A		
Cash Receipt No's:			WATER		SANITARY			STORM			
CURB FROM PROPER	TY LINE	N/A	-4					PAVEMEN	NT WIDTH	8m	
B.C. HYDRO	Overhead										
B.C. TELEPHONE	Overhead										
TERASEN	42 PROP/P	.E.									
Information Sheets:	REFERENC	E DRAWING	SS L&M ENGINE	ERING LIMITED	JOB NO. 1	256-07	-04				
Comments:		JRB STOP EAN OUT		WATER SERVICE STORM SERVICE SANITARY SERVI	CE		YDRO ABLE S	SERVICE SERVICE MMUNICASTI	- 24 - 24 - 1	GAS ELECTRICAL	
	TI 15 14										

THE INFORMATION CONTAINED HEREIN IS FOR INTERNAL USE ONLY.

NOT TO BE RELIED UPON UNLESS CONFIRMED BY THE SITE INSPECTION AND/OR INVESTIGATION

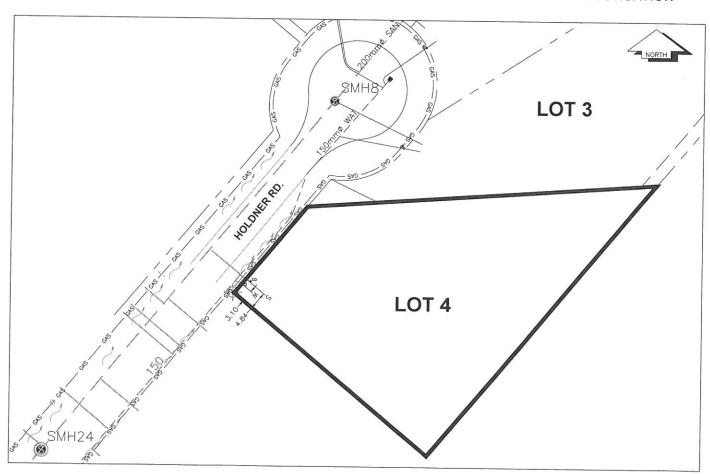

I ot 4

SANITARY, STORM & WATER SERVICE INVERTS	SANITARY	WATER	STORM
1. Distance from San. M.H. 24 toward San. M.H. 8 to lot service connection point is:	70m	N/A	N/A
1a.Distance from Stm. M.H toward Stm. M.H to lot service connection point is:	N/A	N/A	N/A
2. Main Size at connection point is	200mm	150mm	N/A
3. Invert of main at conn. stub point is	738.94	739.90	N/A
4. Invert at service end is	740.47	740.03	N/A
5. Cut at property line in meters	2.54	3.17	N/A
6. Survey Date: AUG. 2012 Book Ref.: 1256-07-04 By: L&M ENGINEERING LTD.			
SANITARY HISTORY:			
Installed By: Fair Value Homes Ltd.			
WATER HISTORY:			
Installed By: Fair Value Homes Ltd.			
,,,,,,,,,,,,,,,,,,,,,,,,,,,,,,,,,,,,,,,			
	**************************************	al Thus see to be	
STORM HISTORY:			
N/A			