



City of Prince George
History Sheet

| | |
|--------|-----------|
| PID: | 028736541 |
| SD/MU: | MU101260 |
| WO: | 62393 |

Civic Address: 1936 Juniper St

Legal Description: Lot: PCL A Block: 343 (CA2304904) District Lot: 343 Plan: 1268


| Service Type | Diameter (mm) | Material | Invert Elev at main (m) | Depth of cut at property line (m) | Invert Elev at service end (m) | Distance into property (m) | Installation Date |
|--------------|---------------|----------|-------------------------|-----------------------------------|--------------------------------|----------------------------|-------------------|
| Sanitary | 100mm | PVC | - | 2.01 | 576.32 | - | - |
| Water | 20mm | Copper | - | - | - | - | Apr 13, 2012 |
| Storm | N/A | N/A | - | - | - | - | |

| Service Connection Location | | | | Sanitary (m) | Storm (m) |
|---------------------------------|------|-------------------------|------|--------------|-----------|
| Distance from downstream San MH | 3314 | towards upstream San MH | 3308 | 69.56 | |
| Distance from downstream Stm MH | - | towards upstream Stm MH | - | | |

| Power | Size | Communications | Size | Cable | Size | Gas | Size |
|------------------|------|------------------|------|------------------|------|----------|------|
| BC Hydro | - | Telus | - | Shaw | - | FortisBC | - |
| Overhead Service | | Overhead Service | | Overhead Service | | | |

| | | | |
|---------------|------------------------------|--------------|---|
| Installed by: | City of Prince George forces | Survey Date: | - |
| Comments: | | | |

NOT TO SCALE The information contained herein is for internal use only.
Not to be relied on unless confirmed by site inspection and/or investigation.

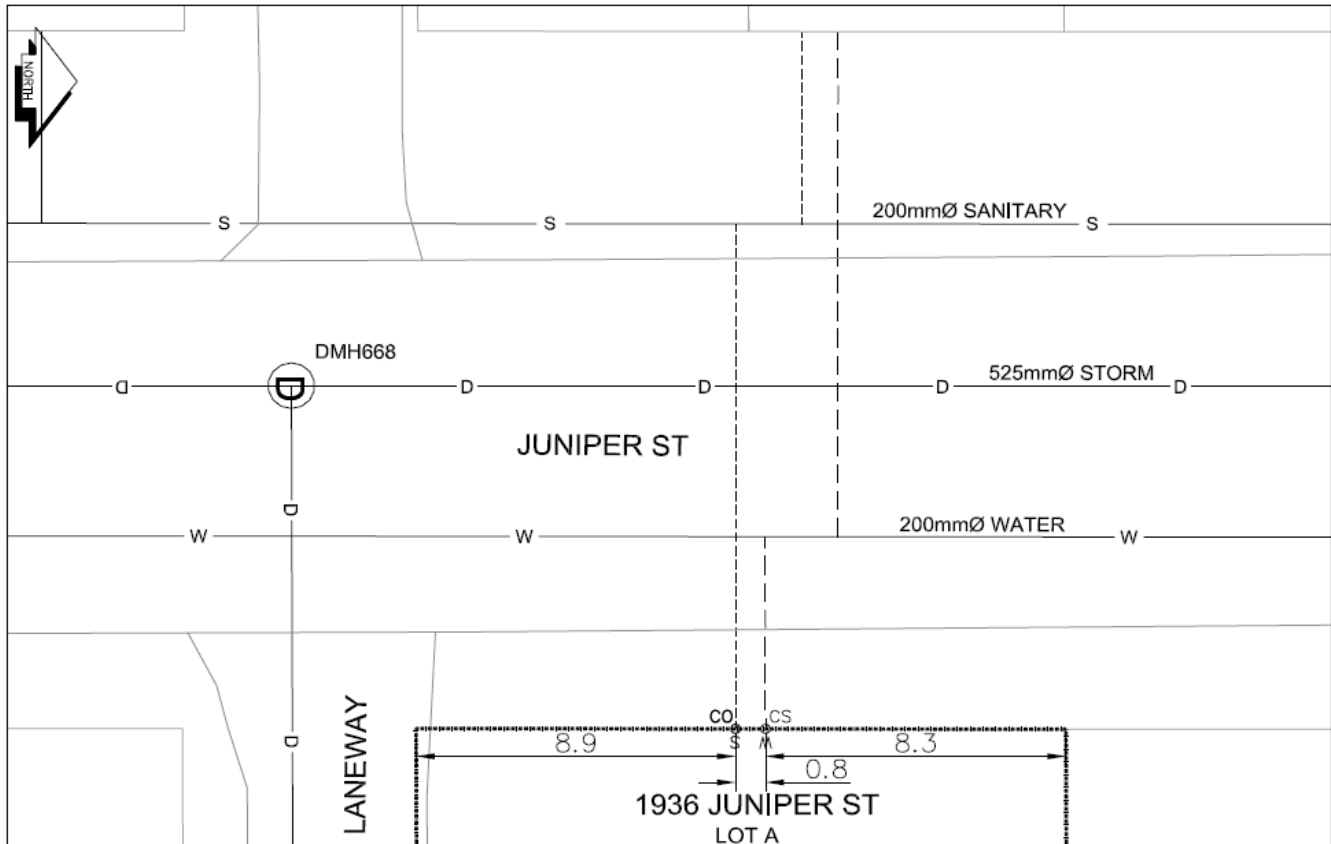

| | | | | | |
|----|-----------|-----|------------------|-----|---------------|
| CS | CURB STOP | --- | WATER SERVICE | --- | STORM SERVICE |
| CO | CLEAN OUT | --- | SANITARY SERVICE | --- | WATER VALVE |

NOT TO SCALE