



# City of Prince George History Sheet

PID:	028759656
MU:	101296
WO:	65350 - 65352

Civic Address: 9690 Penn Rd

Legal Description: Lot: A District Lot: 751 Plan: EPP14328


Service Type	Diameter (mm)	Material	Invert Elev at main (m)	Invert Elev at property line (m)	Invert Depth at service end (m)	Distance into property (m)	Installation Date
Sanitary	100mm	PVC	585.89	586.23	1.60	-	May 2012
Water	50mm	Copper	585.58	585.81	-	-	May 2012
Storm (South)	450mm	PVC	585.94	586.21	1.63	-	May 2012

Service Connection Location	Sanitary (m)	Storm (m)
100mm Sanitary service connected to San MH4718	-	
450mm Storm service connected to Stm MH1147		

Power	Size	Communications	Size	Cable	Size	Gas	Size
BC Hydro	-	Telus	-	Shaw	-	FortisBC	-
Overhead Service		Overhead Service		Overhead Service			

Installed by:	City of Prince George forces	Survey Date:	-
Comments:			

**NOT TO SCALE** The information contained herein is for internal use only.  
Not to be relied on unless confirmed by site inspection and/or investigation.

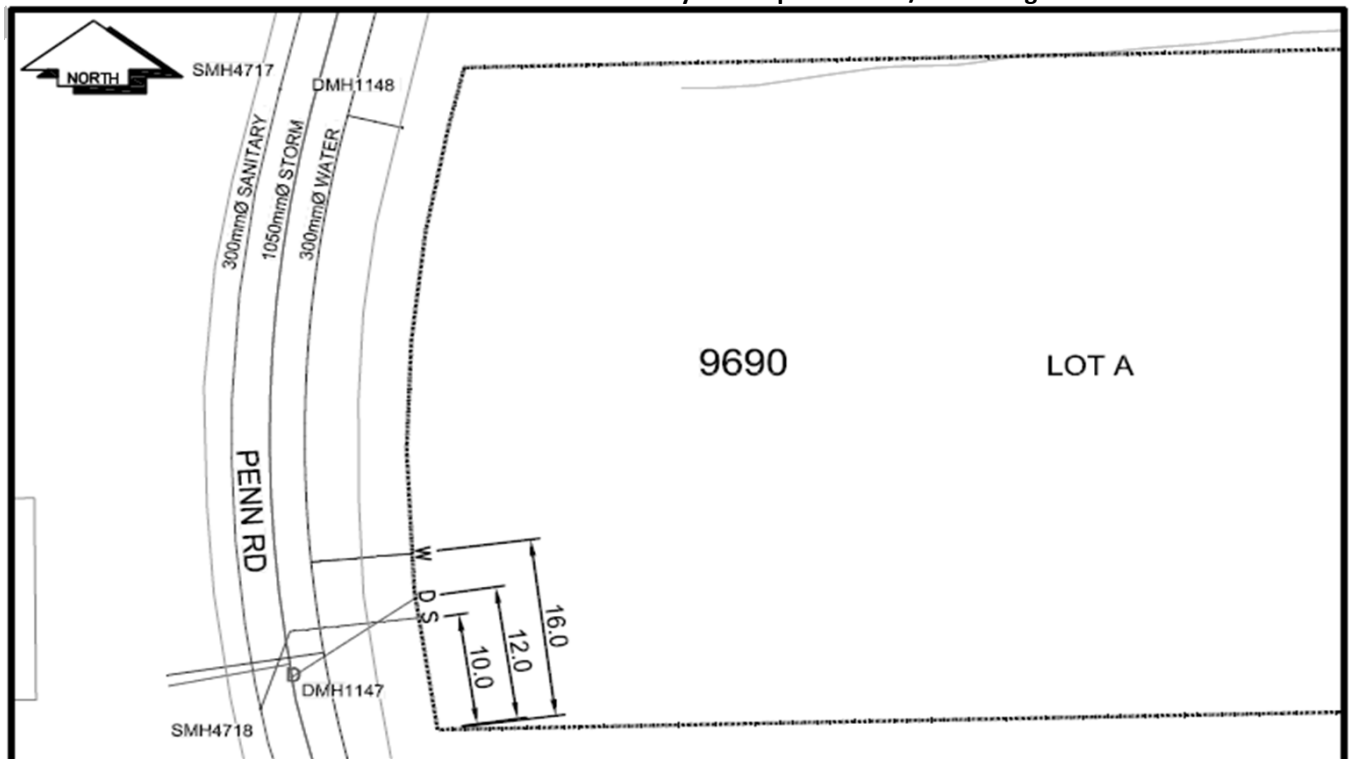

CS <sup>o</sup> CURB STOP	---X--- WATER SERVICE	---o--- STORM SERVICE
CO <sup>o</sup> CLEAN OUT	---S--- SANITARY SERVICE	---G--- GAS
⊗ WATER VALVE	⊗ FIRE HYDRANT	--- --- ENCUMBRANCE

**NOT TO SCALE**