

City of Prince George

HISTORY SHEET

PID: 028331052

Scale: 1:500

Legal: LOT 24

D.L.: 2014

PLAN: EPP5390

Address: - 7492 & 7496 Creekside Way


Sanitary Connection:#	SIZE: 100mmØ	MATERIAL: PVC	INV. 584.40	CONNECTED
Water Connection:#	SIZE: 19mmØ	MATERIAL: copper	INV. 584.13	METER
Storm Connection:#	SIZE 100mmØ	MATERIAL PVC	INV. 584.17	CONNECTED
Cash Receipt No's:	WATER	SANITARY	STORM	
CURB FROM PROPERTY LINE	5m	PAVEMENT WIDTH	10m	
B.C. HYDRO	75mm DB2	U/G CONNECTION	✓	
B.C. TELEPHONE	50mm DB2	U/G CONNECTION	✓	
TERASEN	42 PROP/P.E.			

Information Sheets: REFERENCE DRAWINGS L&M ENGINEERING LIMITED JOB NO. 1140-07-04

Comments: CS CURB STOP SDW WATER SERVICE SDW HYDRO SERVICE
CO CLEAN OUT SDW STORM SERVICE SDW CABLE SERVICE
SDW SANITARY SERVICE SDW TELECOMMUNICATIONS SDW GAS
ELECTRICAL

THE INFORMATION CONTAINED HEREIN IS FOR INTERNAL USE ONLY.

NOT TO BE RELIED UPON UNLESS CONFIRMED BY THE SITE INSPECTION AND/OR INVESTIGATION

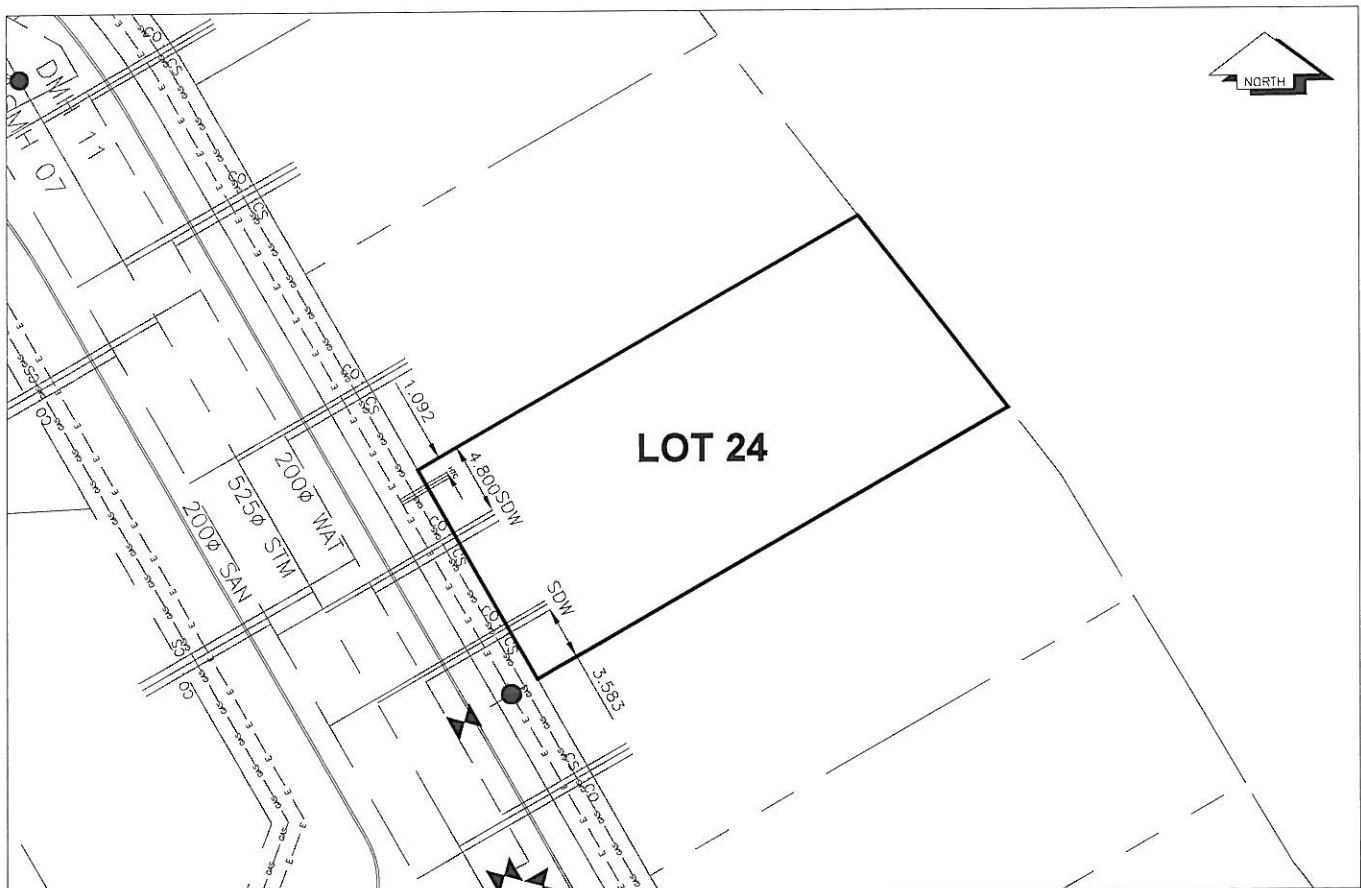

SANITARY, STORM & WATER SERVICE INVERTS NORTH	SANITARY	WATER	STORM
1. Distance from San. M.H. <u>07</u> toward San. M.H. <u>08</u> to lot service connection point is:	40m	N/A	N/A
1a.Distance from Stm. M.H. <u>11</u> toward Stm. M.H. <u>12</u> to lot service connection point is:	N/A	N/A	41m
2. Main Size at connection point is	200mmØ	200mmØ	525mmØ
3. Invert of main at conn. stub point is	582.28	583.72	582.52
4. Invert at service end is	584.40	584.13	584.17
5. Cut at property line in meters	2.56	2.91	2.79
6. Survey Date: OCT 2009 Book Ref.: 1140-07-04 By: FORESIGHT SURVEY & DESIGN			
SANITARY, STORM & WATER SERVICE INVERTS SOUTH	SANITARY	WATER	STORM
1. Distance from San. M.H. <u>07</u> toward San. M.H. <u>08</u> to lot service connection point is:	47m	N/A	N/A
1a.Distance from Stm. M.H. <u>11</u> toward Stm. M.H. <u>12</u> to lot service connection point is:	N/A	N/A	48m
2. Main Size at connection point is	200mmØ	200mmØ	525mmØ
3. Invert of main at conn. stub point is	582.29	583.70	582.42
4. Invert at service end is	584.33	583.99	584.25
5. Cut at property line in meters	2.61m	2.79m	2.69m
6. Survey Date: OCT 2009 Book Ref.: 1140-07-04 By: FORESIGHT SURVEY & DESIGN			

SANITARY HISTORY:

Installed By: Fortwood Homes Ltd.

WATER HISTORY:

Installed By: Fortwood Homes Ltd.

STORM HISTORY:

Installed By: Fortwood Homes Ltd.