

2012-05-28

# City of Prince George

## HISTORY SHEET

PID: 028847831

Scale: 1:500

Legal: LOT 8

D.L.: 2014

PLAN: EPP16518

Address: 7687 Stillwater Cres


Sanitary Connection:#	SIZE: 100mmØ	MATERIAL: PVC	INV. 584.34	CONNECTED
Water Connection:#	SIZE: 19mmØ	MATERIAL: copper	INV. 583.83	METER
Storm Connection:#	SIZE 100mmØ	MATERIAL PVC	INV. 584.10	CONNECTED
Cash Receipt No's:	WATER	SANITARY	STORM	
CURB FROM PROPERTY LINE	5m		PAVEMENT WIDTH	8.5m
B.C. HYDRO	75mm DB2	U/G CONNECTION	✓	
B.C. TELEPHONE	50mm DB2	U/G CONNECTION	✓	
TERASEN	42 PROP/P.E.			

Information Sheets: REFERENCE DRAWINGS L&M ENGINEERING LIMITED JOB NO. 1140-07-04

Comments: CS<sub>O</sub> CURB STOP SDW WATER SERVICE SDW HYDRO SERVICE SDW CABLE SERVICE SDW TELECOMMUNICATIONS GAS GAS E ELECTRICAL  
CO CLEAN OUT SANITARY SERVICE

THE INFORMATION CONTAINED HEREIN IS FOR INTERNAL USE ONLY.

NOT TO BE RELIED UPON UNLESS CONFIRMED BY THE SITE INSPECTION AND/OR INVESTIGATION

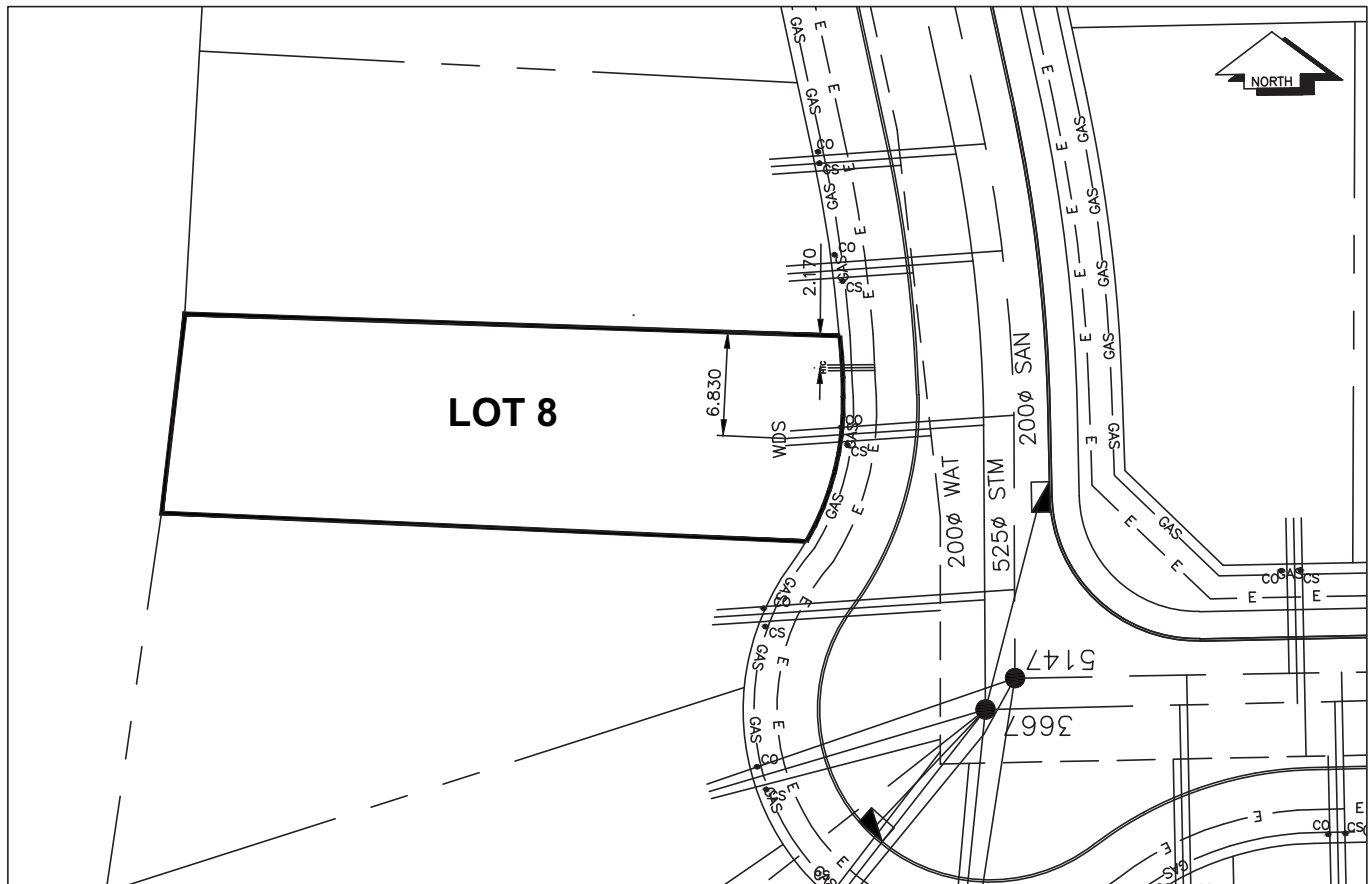

SANITARY, STORM & WATER SERVICE INVERTS	SANITARY	WATER	STORM
1. Distance from San. M.H. <u>5147</u> toward San. M.H. <u>5148</u> to lot service connection point is:	18m	N/A	N/A
1a.Distance from Stm. M.H. <u>3667</u> toward Stm. M.H. <u>3668</u> to lot service connection point is:	N/A	N/A	19m
2. Main Size at connection point is	200mm	200mm	525mm
3. Invert of main at conn. stub point is	582.34	583.58	582.41
4. Invert at service end is	584.34	583.83	584.10
5. Cut at property line in meters	2.33m	2.84m	2.57m
6. Survey Date: OCT 2009    Book Ref.: 1140-07-04    By: FORESIGHT SURVEY & DESIGN			

**SANITARY HISTORY:**

Installed By: Fortwood Homes Ltd.

**WATER HISTORY:**

Installed By: Fortwood Homes Ltd.

**STORM HISTORY:**

Installed By: Fortwood Homes Ltd.