
City of Prince George HISTORY SHEET

PID: 028847890	Scale: 1:500								
Legal: LOT 14						D.L.: 2014	1	PLAN: EPP16518	
Address: 8025 Stillw	ater Cres								
Sanitary Connection:#		SIZE:	100mmØ	MATERIAL:	PVC	INV.	584.60	CONNECTED	
Water Connection:#		SIZE:	19mmØ	MATERIAL:	copper	INV.	584.19	METER	
Storm Connection:#		SIZE	100mmØ	MATERIAL	PVC	INV.	584.58	CONNECTED	
Cash Receipt No's:			WATER		SANITAR	Y		STORM	
CURB FROM PROPERTY LINE 5m PAVEMENT WIDTH				NT WIDTH 8.5m					
B.C. HYDRO	75mm DB2				U/G CONNE	CTION	/		
B.C. TELEPHONE	50mm DB2				U/G CONNE	CTION	/		
TERASEN	42 PROP/P.E	Ē.							
Information Sheets:	REFERENCE	REFERENCE DRAWINGS L&M ENGINEERING LIMITED JOB NO. 1140-07-04							
Comments:	CS CUF	RB STOP		WATER SERVICE STORM SERVICE SANITARY SERV	ICE	ー HYDRO CABLE TELEC	SERVICE SERVICE OMMUNICAS	— GAS— GAS TIONS — E — ELECTRICAL	

THE INFORMATION CONTAINED HEREIN IS FOR INTERNAL USE ONLY.

NOT TO BE RELIED UPON UNLESS CONFIRMED BY THE SITE INSPECTION AND/OR INVESTIGATION

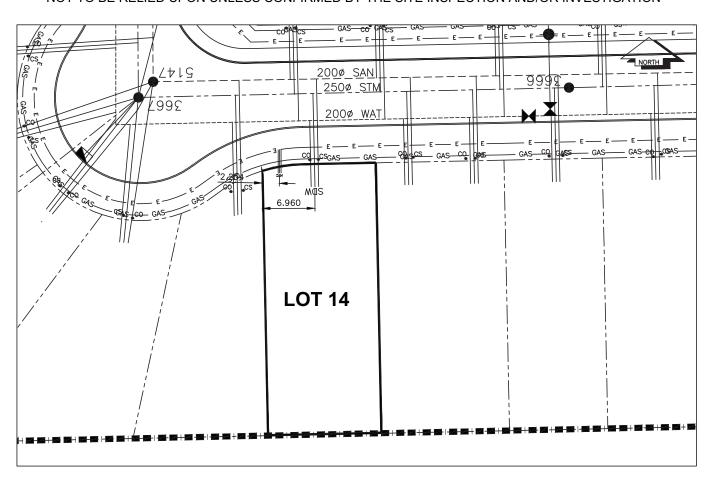

SANITARY, STORM & WATER SERVICE INVERTS	SANITARY	WATER	STORM
1. Distance from San. M.H. <u>5147</u> toward San. M.H. <u>5146</u> to lot service connection point is:	23m	N/A	N/A
1a.Distance from Stm. M.H. 3667 toward Stm. M.H. 3666 to lot service connection point is:	N/A	N/A	24m
2. Main Size at connection point is	200mm	200mm	250mm
3. Invert of main at conn. stub point is	582.34	583.58	582.41
4. Invert at service end is	584.60	584.19	584.58
5. Cut at property line in meters	2.52m	2.93m	2.54m
6. Survey Date: OCT 2009 Book Ref.: 1140-07-04 By: FORESIGHT SURVEY & DESIGN			
		I	_I
SANITARY HISTORY:			
Installed By: Fortwood Homes Ltd.			
WATER HICTORY.			
WATER HISTORY:			
Installed By: Fortwood Homes Ltd.			
STORM HISTORY:			
Installed By: Fortwood Homes Ltd.			
installed by Follwood Florites Ltd.			