
City of Prince George HISTORY SHEET

PID: 028847946	Scale: 1:500								
_egal: LOT 19			D.L.: 20		4 PLAN		EPP16518		
Address: 8065 Stillwa	ater Cres								
Sanitary Connection:#		SIZE:	100mmØ	MATERIAL:	PVC	INV.	584.38	CONN	ECTED
Water Connection:#		SIZE:	19mmØ	MATERIAL:	copper	INV.	584.01	METE	R
Storm Connection:#		SIZE	100mmØ	MATERIAL	PVC	INV.	584.38	CONN	ECTED
Cash Receipt No's:			WATER		SANITAR	Y	STORM		
CURB FROM PROPERTY LINE 5m PAVE				PAVEME	EMENT WIDTH 8.5m				
B.C. HYDRO	75mm DB2				U/G CONNE	ECTION	<u> </u>		
B.C. TELEPHONE	50mm DB2				U/G CONNE	ECTION	<u> </u>		
TERASEN	42 PROP/P.E	<u>.</u>							
Information Sheets:	REFERENCE	REFERENCE DRAWINGS L&M ENGINEERING LIMITED JOB NO. 1140-07-04							
Comments:	CS CURB STOP								

THE INFORMATION CONTAINED HEREIN IS FOR INTERNAL USE ONLY.

NOT TO BE RELIED UPON UNLESS CONFIRMED BY THE SITE INSPECTION AND/OR INVESTIGATION

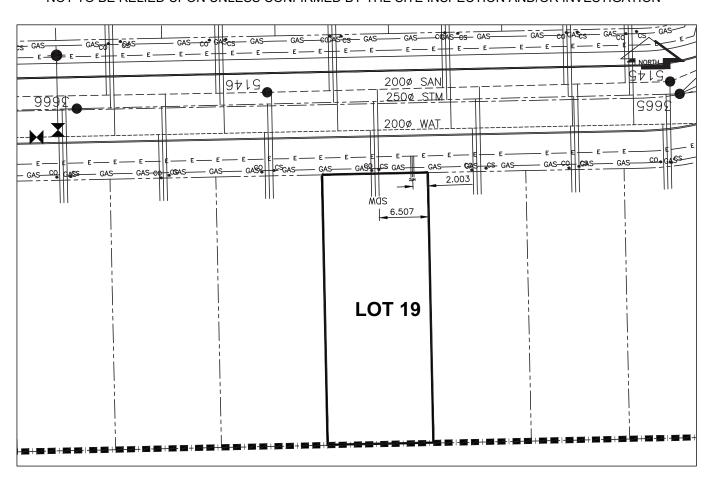

CANITADY STORM & WATER SERVICE INVERTS	SANITARY	WATER	Lot 19 STORM
SANITARY, STORM & WATER SERVICE INVERTS	1		
1. Distance from San. M.H. <u>5146</u> toward San. M.H. <u>5145</u> to lot service connection point is:	15m	N/A	N/A
1a.Distance from Stm. M.H. 3666 toward Stm. M.H. 3665 to lot service connection point is:	N/A	N/A	38m
2. Main Size at connection point is	200mm	200mm	250mm
3. Invert of main at conn. stub point is	582.34	583.58	582.41
4. Invert at service end is	584.38	584.01	584.38
5. Cut at property line in meters	2.72m	2.79m	2.77m
6. Survey Date: OCT 2009 Book Ref.:1140-07-04 By: FORESIGHT SURVEY & DESIGN			
			+
			+
			+
		<u> </u>	
SANITARY HISTORY:			
Installed By: Fortwood Homes Ltd.			
•			
WATER HISTORY:			
Installed By: Fortwood Homes Ltd.			
installed by. Fortwood Florites Etd.			
STORM HISTORY:			
Installed By: Fortwood Homes Ltd.			