
City of Prince George HISTORY SHEET

PID: 028848039					:	Scale: 1:500				
Legal: LOT 25					I	D.L.: 201	4	PLAN: EPP16518		
Address: 8076 Stillwa	ater Cres									
Sanitary Connection:#		SIZE:	100mmØ	MATERIAL:	PVC	INV.	584.45	CONNECTED		
Water Connection:#		SIZE:	19mmØ	MATERIAL:	copper	INV.	584.07	METER		
Storm Connection:#		SIZE	100mmØ	MATERIAL	PVC	INV.	584.47	CONNECTED		
Cash Receipt No's:			WATER		SANITARY	Y		STORM		
CURB FROM PROPER	TY LINE	5m					PAVEME	NT WIDTH 8.5m		
B.C. HYDRO	75mm DB2				U/G CONNE	CTION	_/			
B.C. TELEPHONE	50mm DB2				U/G CONNE	CTION	_/			
TERASEN	42 PROP/P.E	<u>.</u>								
Information Sheets:	REFERENCE	REFERENCE DRAWINGS L&M ENGINEERING LIMITED JOB NO. 1140-07-04								
Comments:	CS CURB STOP WATER SERVICE — ☐ HYDRO SERVICE — GAS— GAS— GAS— GAS— GAS— GAS— GAS— GA									

THE INFORMATION CONTAINED HEREIN IS FOR INTERNAL USE ONLY.

NOT TO BE RELIED UPON UNLESS CONFIRMED BY THE SITE INSPECTION AND/OR INVESTIGATION

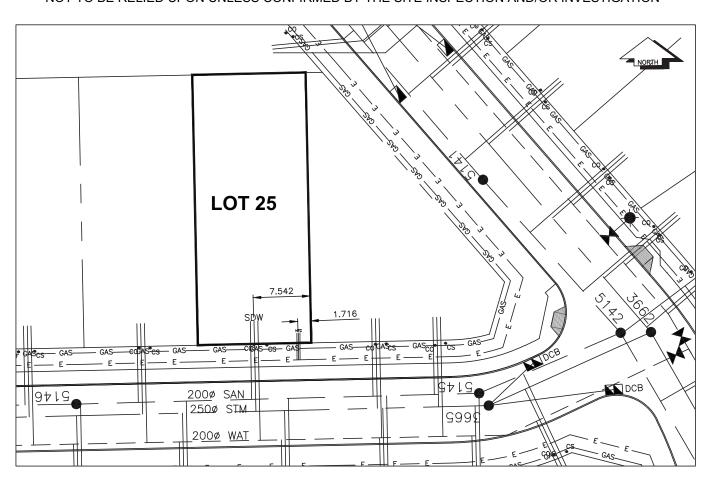

SANITARY, STORM & WATER SERVICE INVERTS	SANITARY	WATER	STORM
1. Distance from San. M.H. <u>5146</u> toward San. M.H. <u>5145</u> to lot service connection point is:	24m	N/A	N/A
1a.Distance from Stm. M.H. 3666 toward Stm. M.H. 3665 to lot service connection point is:	N/A	N/A	49m
2. Main Size at connection point is	200mm	200mm	250mm
3. Invert of main at conn. stub point is	582.34	583.58	582.41
4. Invert at service end is	584.45	584.07	584.47
5. Cut at property line in meters	2.70m	3.08m	2.68m
6. Survey Date: OCT 2009 Book Ref.: 1140-07-04 By: FORESIGHT SURVEY & DESIGN			
	I		
SANITARY HISTORY:			
Installed By: Fortwood Homes Ltd.			
-			
MATER HIGTORY			
WATER HISTORY:			
Installed By: Fortwood Homes Ltd.			
STORM HISTORY:			
Installed By: Fortwood Homes Ltd.			