

2012-05-28

# City of Prince George

## HISTORY SHEET

PID: 028848080

Scale: 1:500

Legal: LOT 30

D.L.: 2014

PLAN: EPP16518

Address: 8026 Stillwater Cres


|                         |              |                  |             |           |
|-------------------------|--------------|------------------|-------------|-----------|
| Sanitary Connection:#   | SIZE: 100mmØ | MATERIAL: PVC    | INV. 584.54 | CONNECTED |
| Water Connection:#      | SIZE: 19mmØ  | MATERIAL: copper | INV. 584.00 | METER     |
| Storm Connection:#      | SIZE 100mmØ  | MATERIAL PVC     | INV. 584.52 | CONNECTED |
| Cash Receipt No's:      | WATER        | SANITARY         | STORM       |           |
| CURB FROM PROPERTY LINE | 5m           | PAVEMENT WIDTH   | 8.5m        |           |
| B.C. HYDRO              | 75mm DB2     | U/G CONNECTION   | ✓           |           |
| B.C. TELEPHONE          | 50mm DB2     | U/G CONNECTION   | ✓           |           |
| TERASEN                 | 42 PROP/P.E. |                  |             |           |

Information Sheets: REFERENCE DRAWINGS L&amp;M ENGINEERING LIMITED JOB NO. 1140-07-04

Comments: CS<sub>O</sub> CURB STOP SDW WATER SERVICE SDW HYDRO SERVICE GAS GAS  
CO CLEAN OUT SDW STORM SERVICE SDW CABLE SERVICE E ELECTRICAL  
SDW SANITARY SERVICE SDW TELECOMMUNICATIONS

THE INFORMATION CONTAINED HEREIN IS FOR INTERNAL USE ONLY.

NOT TO BE RELIED UPON UNLESS CONFIRMED BY THE SITE INSPECTION AND/OR INVESTIGATION

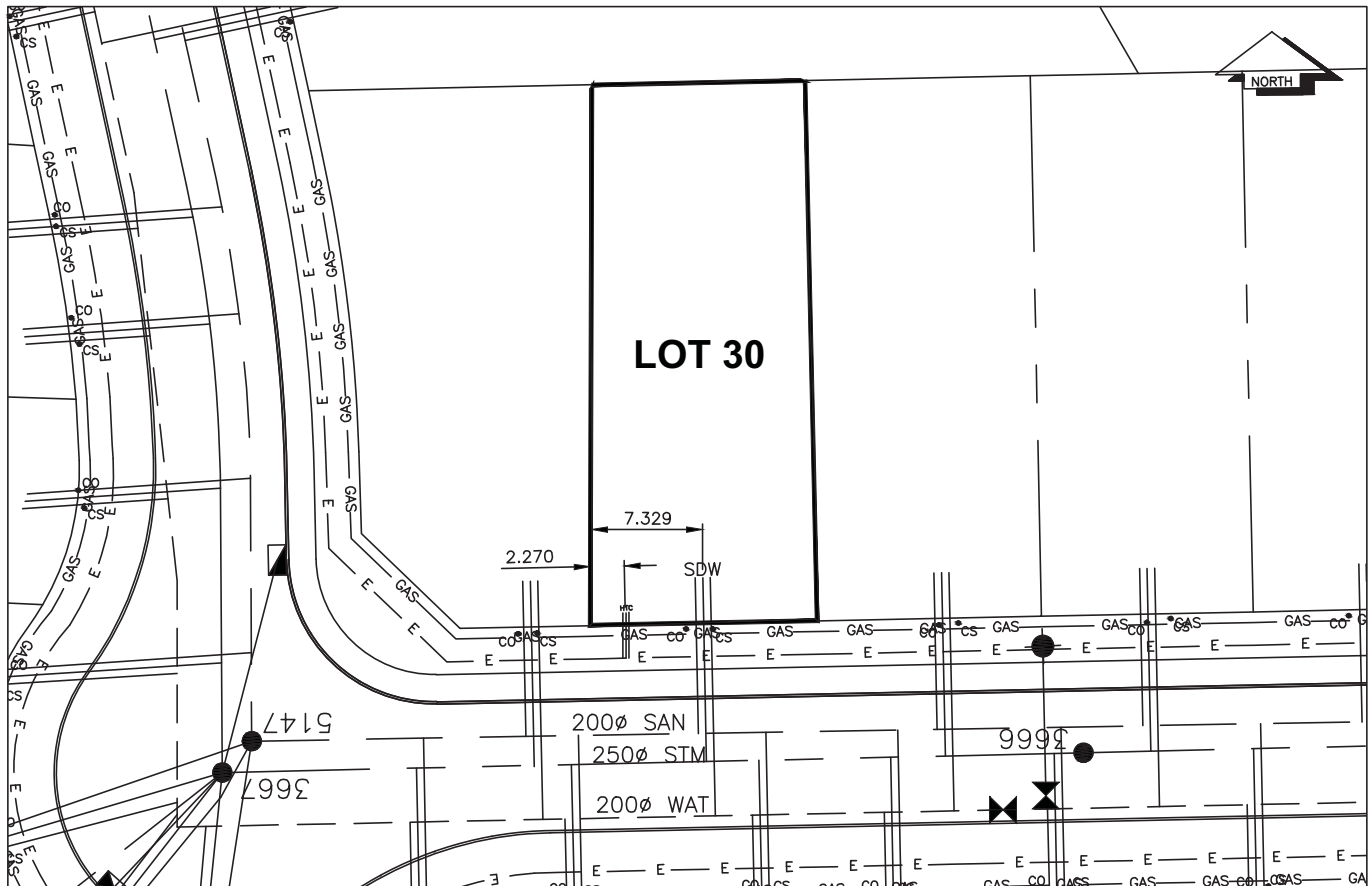

| SANITARY, STORM & WATER SERVICE INVERTS                                                                 | SANITARY | WATER  | STORM  |
|---------------------------------------------------------------------------------------------------------|----------|--------|--------|
| 1. Distance from San. M.H. <u>5146</u> toward San. M.H. <u>5147</u> to lot service connection point is: | 50m      | N/A    | N/A    |
| 1a.Distance from Stm. M.H. <u>3666</u> toward Stm. M.H. <u>3667</u> to lot service connection point is: | N/A      | N/A    | 25m    |
| 2. Main Size at connection point is                                                                     | 200mm    | 200mm  | 250mm  |
| 3. Invert of main at conn. stub point is                                                                | 582.34   | 583.58 | 582.41 |
| 4. Invert at service end is                                                                             | 584.54   | 584.00 | 584.52 |
| 5. Cut at property line in meters                                                                       | 2.58m    | 3.22m  | 2.70m  |
| 6. Survey Date: OCT 2009    Book Ref.: 1140-07-04    By: FORESIGHT SURVEY & DESIGN                      |          |        |        |
|                                                                                                         |          |        |        |
|                                                                                                         |          |        |        |
**SANITARY HISTORY:**

Installed By: Fortwood Homes Ltd.

**WATER HISTORY:**

Installed By: Fortwood Homes Ltd.

**STORM HISTORY:**

Installed By: Fortwood Homes Ltd.