
## City of Prince George HISTORY SHEET

PID: 28848110		Scale: 1:500						
Legal: LOT 33		Γ			D.L.: 2014		PLAN: EPP16518	
Address: 7670 CREE	KSIDE WAY							
Sanitary Connection:#		SIZE:	100mmØ	MATERIAL:	PVC	INV.	584.08	CONNECTED
Water Connection:#		SIZE:	19mmØ	MATERIAL:	copper	INV.	583.43	METER
Storm Connection:#		SIZE	100mmØ	MATERIAL	PVC	INV.	584.08	CONNECTED
Cash Receipt No's:			WATER		SANITAR	Υ		STORM
CURB FROM PROPER	TY LINE	5m					PAVEME	NT WIDTH 8.5m
B.C. HYDRO	75mm DB2				U/G CONNE	ECTION	_/	
B.C. TELEPHONE	50mm DB2				U/G CONNE	ECTION	_/	
TERASEN	42 PROP/P.E	Ī.						
Information Sheets:	REFERENCE DRAWINGS L&M ENGINEERING LIMITED JOB NO. 1140-07-04							
Comments:	CS CURB STOP WATER SERVICE THYDRO SERVICE GAS—GAS—GAS—CO CLEAN OUT SANITARY SERVICE TELECOMMUNICASTIONS ELECTRICAL						- FLECTRICAL	

THE INFORMATION CONTAINED HEREIN IS FOR INTERNAL USE ONLY.

NOT TO BE RELIED UPON UNLESS CONFIRMED BY THE SITE INSPECTION AND/OR INVESTIGATION

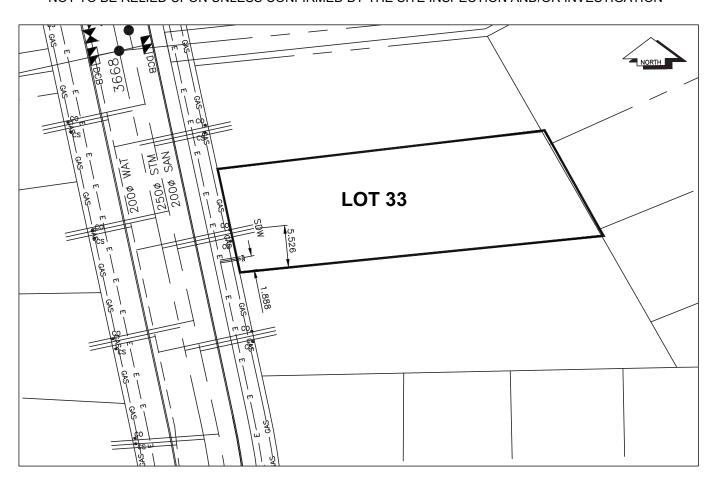

SANITARY, STORM & WATER SERVICE INVERTS	SANITARY	WATER	STORM
1. Distance from San. M.H. <u>5147</u> toward San. M.H. <u>5148</u> to lot service connection point is:	61m	N/A	N/A
1a.Distance from Stm. M.H. 3667 toward Stm. M.H. 3668 to lot service connection point is:	N/A	N/A	64m
2. Main Size at connection point is	200mm	200mm	250mm
3. Invert of main at conn. stub point is	582.34	583.58	582.41
4. Invert at service end is	584.08	583.43	584.08
5. Cut at property line in meters	2.25m	2.90m	2.25m
6. Survey Date: OCT 2009 Book Ref.: 1140-07-04 By: FORESIGHT SURVEY & DESIGN			
SANITARY HISTORY:			
Installed By: Fortwood Homes Ltd.			
Installed by Follwood Florings Etc.			
WATER HISTORY:			
Installed By: Fortwood Homes Ltd.			
STORM HISTORY:			
Installed By: Fortwood Homes Ltd.			