
## City of Prince George HISTORY SHEET

PID: 028848209	3209 Scale: 1:500										
Legal: LOT 42				D.L.: 2014			PLAN: EPP16518				
Address: 7653 Creek	side Way										
Sanitary Connection:#		SIZE:	100mmØ	MATERIAL:	PVC	II	NV.	583.53	С	ONNECTED	
Water Connection:#		SIZE:	19mmØ	MATERIAL:	copper	11	NV.	583.25	N	METER	
Storm Connection:#		SIZE	100mmØ	MATERIAL	PVC	11	NV.	583.59	С	ONNECTED	
Cash Receipt No's:			WATER	ATER SANITAI			RY S			TORM	
CURB FROM PROPERTY LINE 5m							PAVEMENT WIDTH 10m				
B.C. HYDRO	75mm DB2				U/G CONN	ECTION		✓			
B.C. TELEPHONE	50mm DB2				U/G CONN	ECTION	ECTION				
TERASEN	42 PROP/P.E	Ē.									
Information Sheets:	REFERENCE DRAWINGS L&M ENGINEERING LIMITED JOB NO. 1140-07-04										
Comments:	CS CURB STOP WATER SERVICE TELECOMMUNICASTIONS — E — ELECTRICAL							AL			

THE INFORMATION CONTAINED HEREIN IS FOR INTERNAL USE ONLY.

NOT TO BE RELIED UPON UNLESS CONFIRMED BY THE SITE INSPECTION AND/OR INVESTIGATION

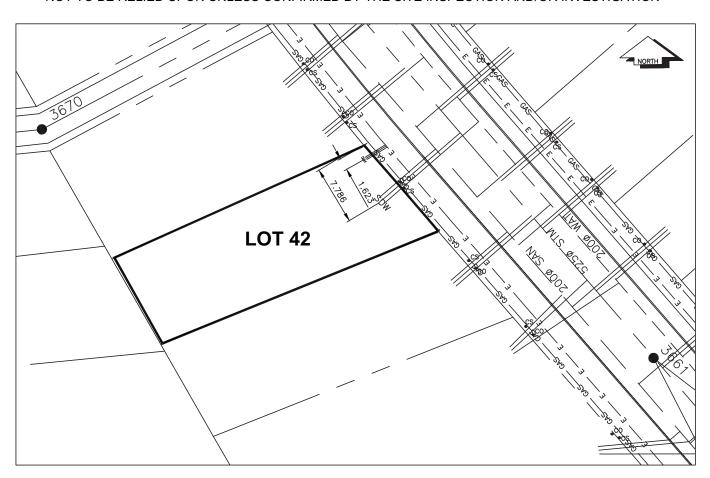

SANITARY, STORM & WATER SERVICE INVERTS	SANITARY	WATER	STORM
1. Distance from San. M.H. <u>5141</u> toward San. M.H. <u>5140</u> to lot service connection point is:	75m	N/A	N/A
1a.Distance from Stm. M.H. 3661 toward Stm. M.H. 3660 to lot service connection point is:	N/A	N/A	59m
2. Main Size at connection point is	200mm	200mm	525mm
3. Invert of main at conn. stub point is	582.34	583.58	582.41
4. Invert at service end is	583.53	583.25	583.59
5. Cut at property line in meters	2.42m	2.70m	2.36m
6. Survey Date: OCT 2009 Book Ref.: 1140-07-04 By: FORESIGHT SURVEY & DESIGN			
	1		1
SANITARY HISTORY:			
Installed By: Fortwood Homes Ltd.			
WATER HISTORY:			
Installed By: Fortwood Homes Ltd.			
Installed by. Follwood Homes Ltd.			
STORM HISTORY:			
Installed By: Fortwood Homes Ltd.			
·			