

2012-05-28

City of Prince George

HISTORY SHEET

PID: 028848217

Scale: 1:500

Legal: LOT 43

D.L.: 2014

PLAN: EPP16518

Address: 7661 Creekside Way


Sanitary Connection:#	SIZE: 100mmØ	MATERIAL: PVC	INV. 583.62	CONNECTED
Water Connection:#	SIZE: 19mmØ	MATERIAL: copper	INV. 583.36	METER
Storm Connection:#	SIZE 100mmØ	MATERIAL PVC	INV. 583.65	CONNECTED
Cash Receipt No's:	WATER	SANITARY	STORM	
CURB FROM PROPERTY LINE	5m	PAVEMENT WIDTH	10m	
B.C. HYDRO	75mm DB2	U/G CONNECTION	✓	
B.C. TELEPHONE	50mm DB2	U/G CONNECTION	✓	
TERASEN	42 PROP/P.E.			

Information Sheets: REFERENCE DRAWINGS L&M ENGINEERING LIMITED JOB NO. 1140-07-04

Comments: CS_O CURB STOP SDW WATER SERVICE HYDRO SERVICE GAS GAS
CO CLEAN OUT STORM SERVICE CABLE SERVICE E ELECTRICAL
SANITARY SERVICE TELECOMMUNICATIONS

THE INFORMATION CONTAINED HEREIN IS FOR INTERNAL USE ONLY.

NOT TO BE RELIED UPON UNLESS CONFIRMED BY THE SITE INSPECTION AND/OR INVESTIGATION

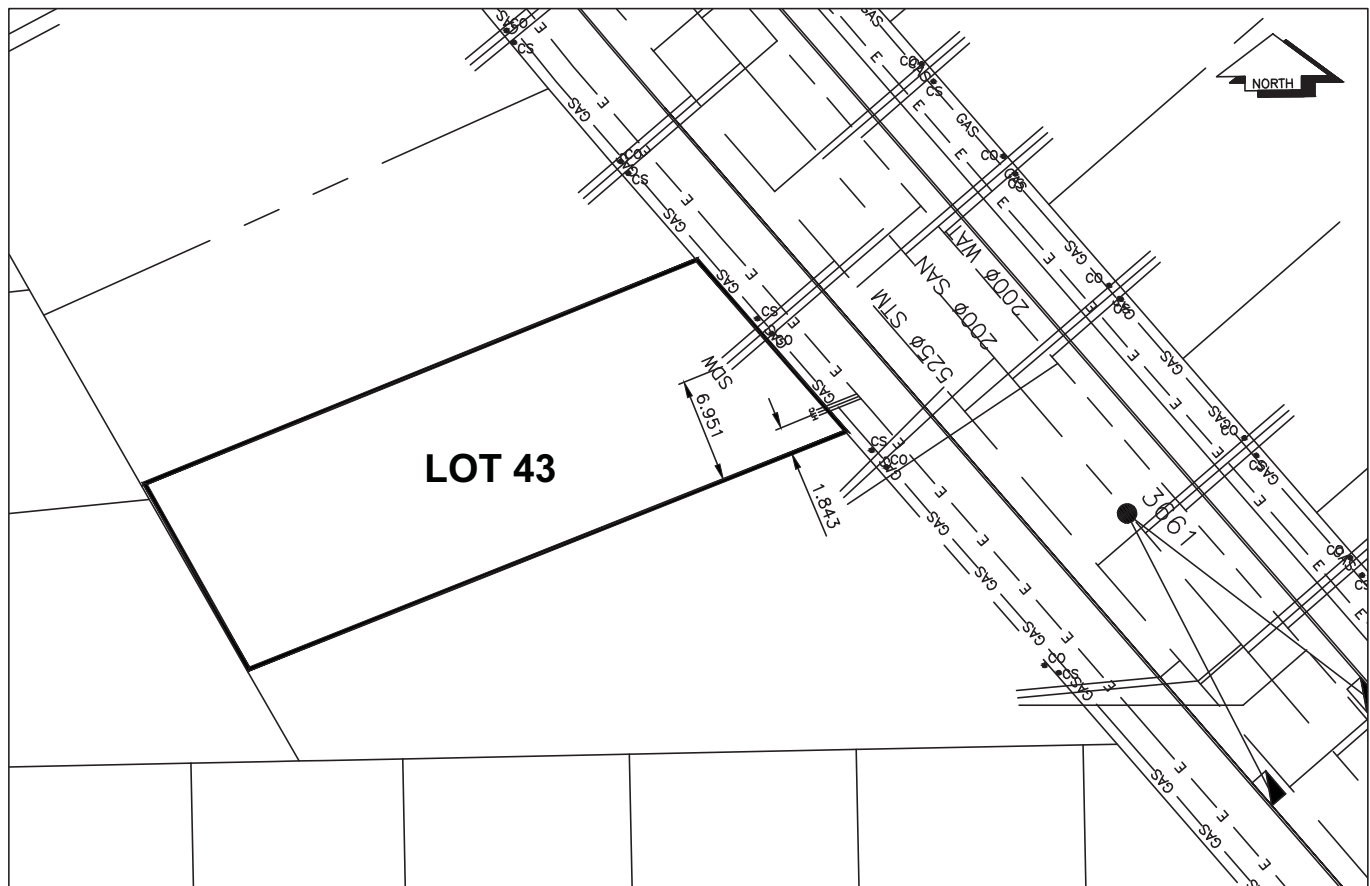

Installed By: Fortwood Homes Ltd.

Installed By: Fortwood Homes Ltd.

Installed By: Fortwood Homes Ltd.