



City of Prince George
History Sheet

PID:	028849671
SD/MU:	
WO:	

Civic Address: 2161 - 2163 Laurier Cres

Legal Description: Lot: A Block: 121 District Lot: 343 Plan: EPP20327


Service Type	Diameter (mm)	Material	Invert Elev at main (m)	Invert Elev at property line (m)	Invert Elev at service end (m)	Distance into property (m)	Installation Date
Sanitary	100mm	PVC	-	-	-	-	-
Water	20mm	Copper	-	-	-	-	-
Storm	N/A	N/A	-	-	-	-	-

Service Connection Location				Sanitary (m)	Storm (m)
Distance from downstream San MH	2674	towards upstream San MH	2679	10.15	
Distance from downstream Stm MH	-	towards upstream Stm MH	-		

Power	Size	Communications	Size	Cable	Size	Gas	Size
BC Hydro	-	Telus	-	Shaw	-	FortisBC	-
Overhead Service		Overhead Service		Overhead Service			

Installed by:	City of Prince George forces tested and confirmed services July 2012	Survey Date:	-
Comments:			

NOT TO SCALE The information contained herein is for internal use only.
Not to be relied on unless confirmed by site inspection and/or investigation.

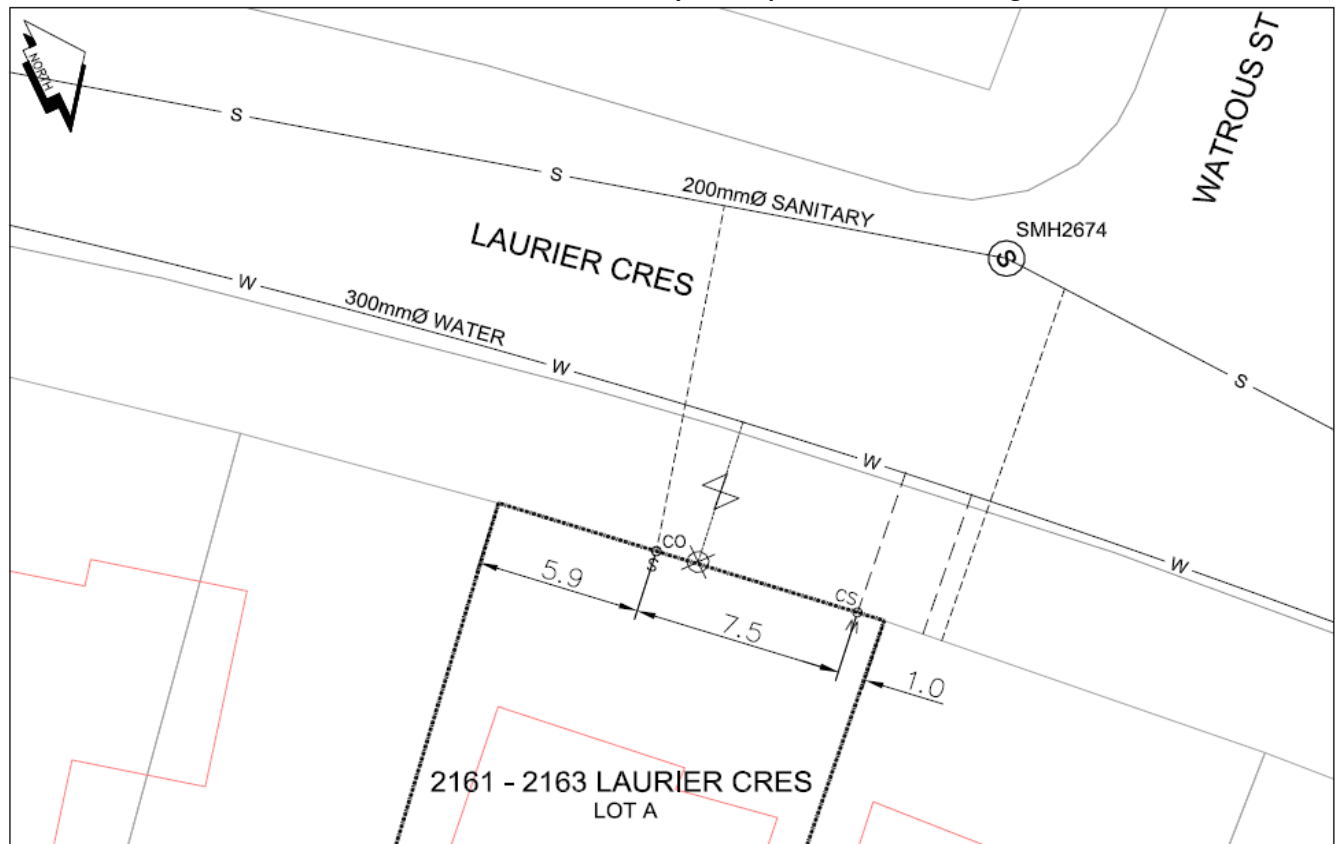

LEGEND:	CS ^o	CURB STOP	---	WATER SERVICE	---	STORM SERVICE
	CO ^o	CLEAN OUT	---	SANITARY SERVICE	---	WATER VALVE

NOT TO SCALE