



City of Prince George
History Sheet

PID:	028849680
MU:	101308
WO:	65410/65411

Civic Address: 2155 - 2157 Laurier Cres

Legal Description: Lot: B Block: 121 District Lot: 343 Plan: EPP20327


Service Type	Diameter (mm)	Material	Invert Elev at main (m)	Invert Elev at property line (m)	Invert Elev at service end (m)	Distance into property (m)	Installation Date
Sanitary	100mm	PVC	-	-	-	-	July 2012
Water	20mm	Copper	-	-	-	-	July 2012
Storm	N/A	N/A	-	-	-	-	

Service Connection Location				Sanitary (m)	Storm (m)
Distance from downstream San MH	999	towards upstream San MH	3674	128.00	
Distance from downstream Stm MH	-	towards upstream Stm MH	-		

Power	Size	Communications	Size	Cable	Size	Gas	Size
BC Hydro	-	Telus	-	Shaw	-	FortisBC	-
Overhead Service		Overhead Service		Overhead Service			

Installed by:	City of Prince George forces	Survey Date:	-
Comments:	Sanitary service replaced by City July 12, 2012; 1/2" water service upgraded to new 3/4" by City July 12, 2012		

NOT TO SCALE The information contained herein is for internal use only.
Not to be relied on unless confirmed by site inspection and/or investigation.

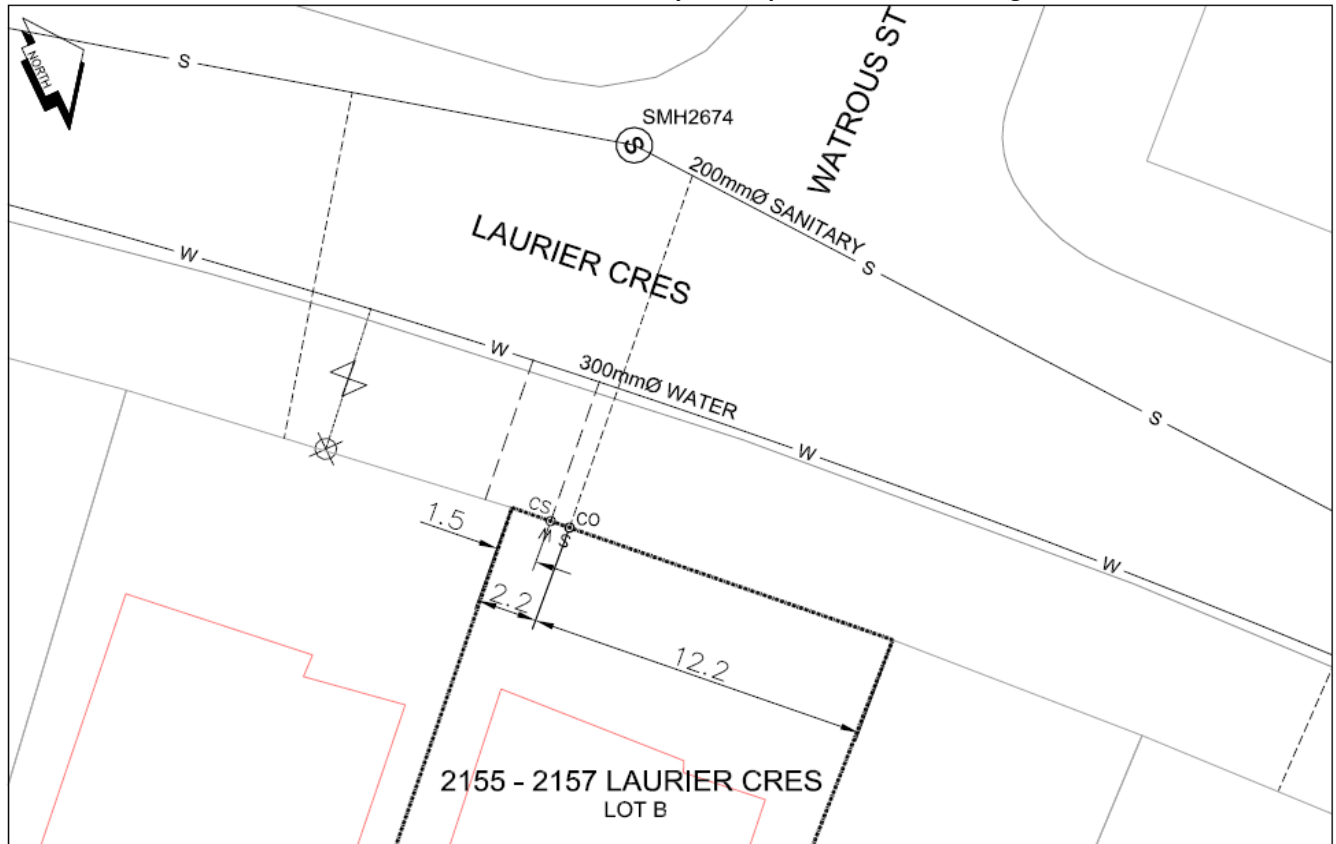

LEGEND:	CS ^o CURB STOP	--- WATER SERVICE	--- STORM SERVICE
	CO ^o CLEAN OUT	--- SANITARY SERVICE	⊗ WATER VALVE

NOT TO SCALE