



City of Prince George History Sheet

PID:	028862104
SD/MU:	
WO:	

Civic Address: 824 La Salle Ave

Legal Description: Lot: 1 District Lot: 933 Plan: EPP21490


Service Type	Diameter (mm)	Material	Invert Elev at main (m)	Invert Elev at property line (m)	Invert Elev at service end (m)	Distance into property (m)	Installation Date
Sanitary (east)	100mm	AC	-	-	-	-	January 1982
Sanitary (west)	100mm	AC	-	-	-	-	January 1982
Water (east)	13mm	Copper	-	-	-	-	January 1955
Water (west)	13mm	Copper	-	-	-	-	January 1955
Storm	N/A	N/A	-	-	-	-	

Service Connection Location				Sanitary (m)	Storm (m)
Distance from downstream San MH	3019	towards upstream San MH	3016	66.60	
Distance from downstream San MH	3019	towards upstream San MH	3016	60.90	

Power	Size	Communications	Size	Cable	Size	Gas	Size
BC Hydro	-	Telus	-	Shaw	-	FortisBC	-
Overhead Service		Overhead Service		Overhead Service			

Installed by:	Survey Date:	-
Comments:		

NOT TO SCALE The information contained herein is for internal use only.
Not to be relied on unless confirmed by site inspection and/or investigation.

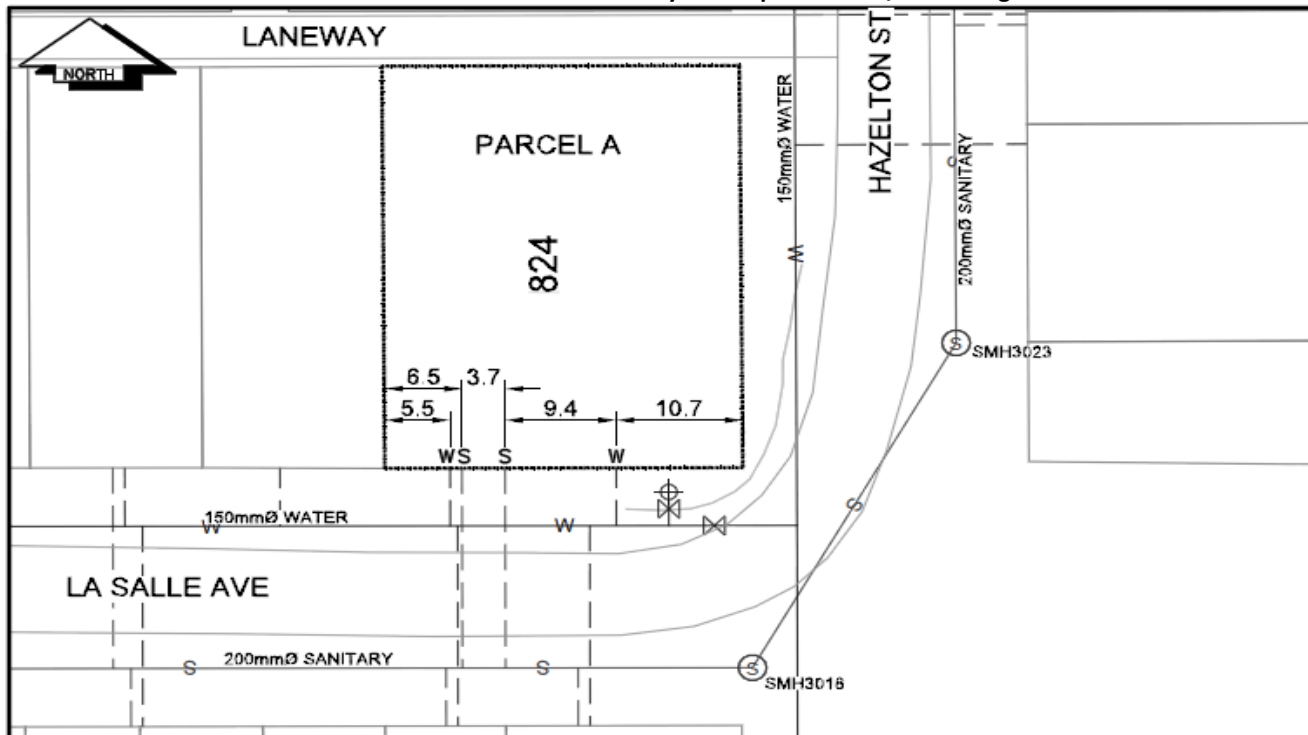

CS CURB STOP	--- WATER SERVICE	--- STORM SERVICE
CO CLEAN OUT	--- SANITARY SERVICE	--- GAS
WV WATER VALVE	--- FIRE HYDRANT	--- ENCUMBRANCE

NOT TO SCALE