



City of Prince George History Sheet

PID:	028887298
MU:	101301
WO:	66099/66100

Civic Address: 2262 Ross Cres

Legal Description: Lot: A District Lot: 343 Block: 118 Plan: EPP4443


Service Type	Diameter (mm)	Material	Invert Elev at main (m)	Depth of cut at property line (m)	Invert Elev at service end (m)	Distance into property (m)	Installation Date
Sanitary	100mm	PVC	-	-	-	-	August 2012
Water	20mm	Copper	-	-	-	-	August 2012
Storm	N/A	N/A	-	-	-	-	

Service Connection Location				Sanitary (m)	Storm (m)
Distance from downstream San MH	1994	towards upstream San MH	1991	91.69	
Distance from downstream Stm MH	-	towards upstream Stm MH	-		

Power	Size	Communications	Size	Cable	Size	Gas	Size
BC Hydro	-	Telus	-	Shaw	-	FortisBC	-
Overhead Service		Overhead Service		Overhead Service			

Installed by:		Survey Date:	-
Comments:	Water and Sanitary service located by UTOPS in 2014		

NOT TO SCALE The information contained herein is for internal use only.
Not to be relied on unless confirmed by site inspection and/or investigation.

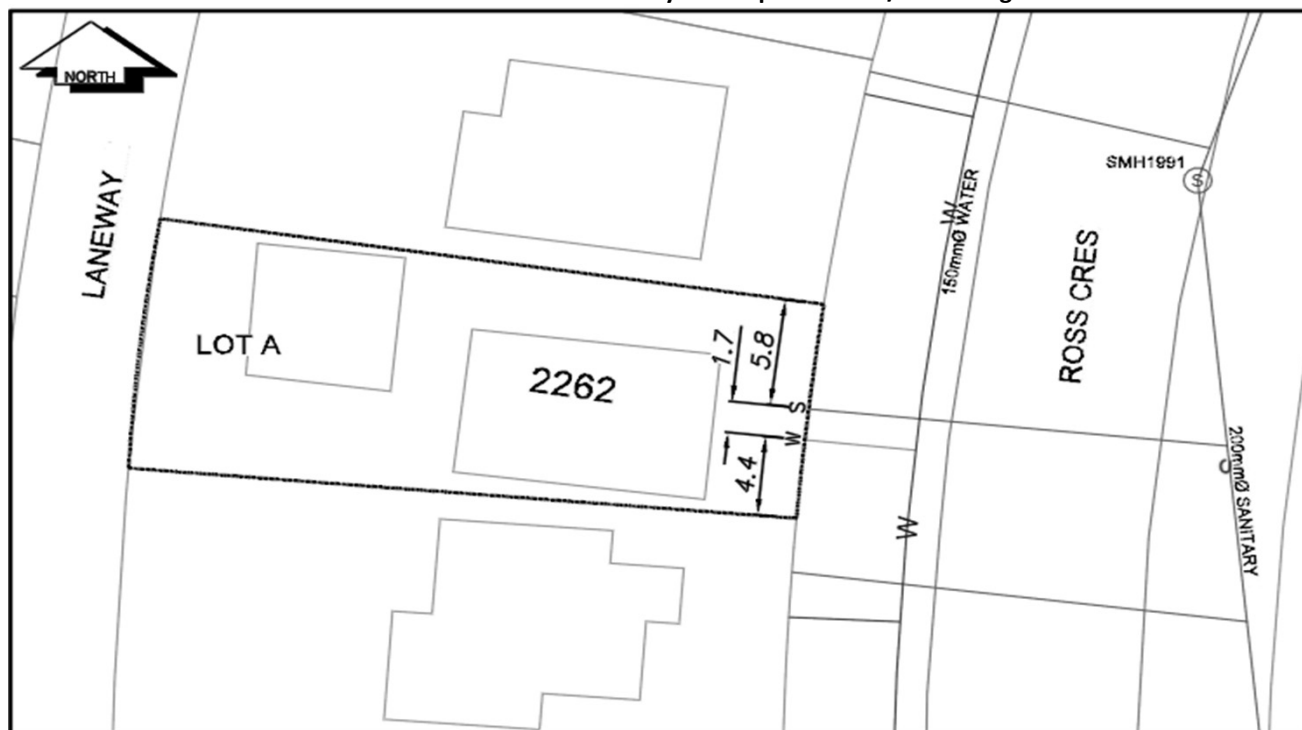

CS CURB STOP	W WATER SERVICE	S STORM SERVICE
CO CLEAN OUT	S SANITARY SERVICE	G GAS
WATER VALVE	FIRE HYDRANT	ENCUMBRANCE

NOT TO SCALE