



City of Prince George
History Sheet

PID:	028891830
SD/MU:	
WO:	

Civic Address: 1011 Victoria St

Legal Description: Lot: 1 District Lot: 343 Plan: EPP14218 except Plan EPP14219


Service Type	Diameter (mm)	Material	Invert Elev at main (m)	Invert Elev at property line (m)	Invert Depth at service end (m)	Distance into property (m)	Installation Date
Sanitary	100mm	AC	-	-	1.37	-	December 1959
Water	50mm	Copper	-	-	-	-	December 1956
Storm	150mm	AC	-	568.38	1.27	-	December 1986

Service Connection Location				Sanitary (m)	Storm (m)
Distance from downstream San MH	751	towards upstream San MH	2865	-	
150mm Storm service connected to Stm Mh728					

Power	Size	Communications	Size	Cable	Size	Gas	Size
BC Hydro	-	Telus	-	Shaw	-	FortisBC	-
Overhead Service		Overhead Service		Overhead Service			

Installed by:	Survey Date:	-
Comments:		

NOT TO SCALE The information contained herein is for internal use only.
Not to be relied on unless confirmed by site inspection and/or investigation.

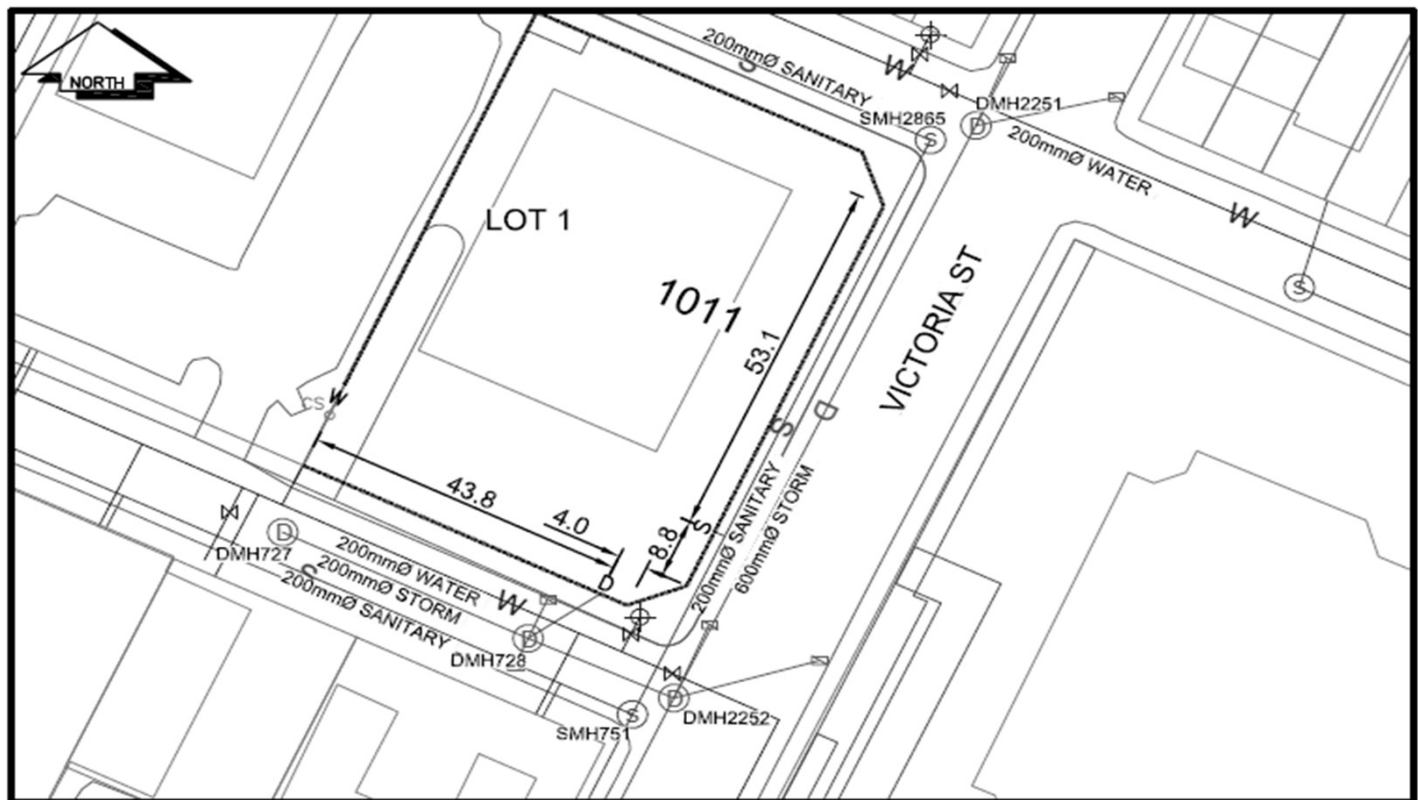

CS CURB STOP	— WATER SERVICE	— STORM SERVICE
CO CLEAN OUT	- - - - - SANITARY SERVICE	— G — GAS
⊗ WATER VALVE	⊗ FIRE HYDRANT	- - - - - ENCUMBRANCE

NOT TO SCALE