



City of Prince George History Sheet

PID:	028900898
SD:	100339
WO:	

Civic Address: 5879 Leland Rd

Legal Description: Lot: 1 District Lot: 1598 Plan: EPP13965


Service Type	Diameter (mm)	Material	Invert Elev at main (m)	Depth of Cut at property line (m)	Invert Elev at service end (m)	Distance into property (m)	Installation Date
Sanitary	100mm	PVC	-	-	-	-	December 2001
Water	20mm	Copper	-	-	-	-	December 2001
Storm	N/A	N/A	-	-	-	-	

Service Connection Location				Sanitary (m)	Storm (m)
Distance from downstream San MH				-	-
Distance from downstream Stm MH				-	-

Power	Size	Communications	Size	Cable	Size	Gas	Size
BC Hydro	-	Telus	-	Shaw	-	FortisBC	-
Overhead Service		Overhead Service		Overhead Service			

Installed by:	City of Prince George forces	Survey Date:	-
Comments:	Water & Sanitary from adjacent lot. Service locations confirmed September 2020.		

NOT TO SCALE The information contained herein is for internal use only.
Not to be relied on unless confirmed by site inspection and/or investigation.

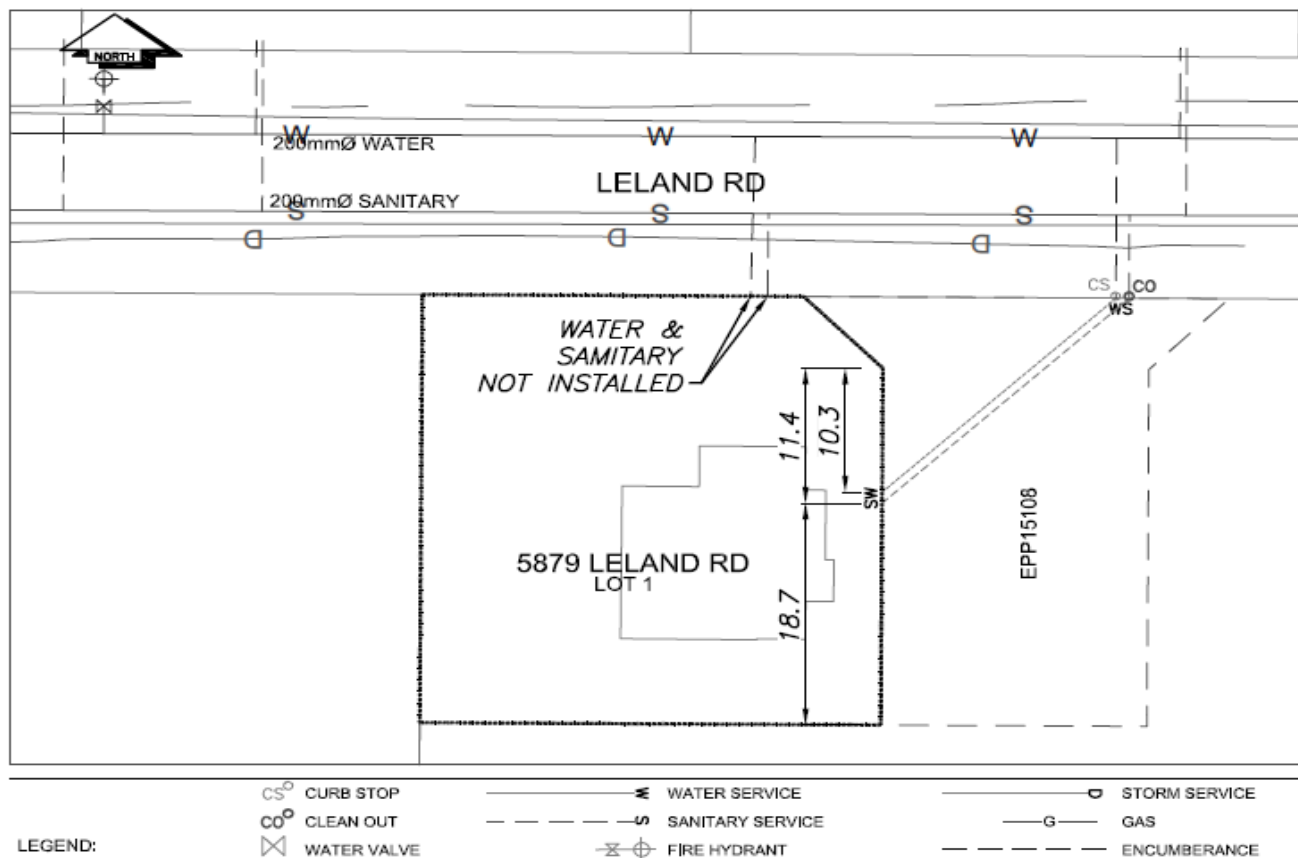

NOT TO SCALE