

# City of Prince George

## HISTORY SHEET

PID: 028904541

Scale: 1:500

Legal: LOT 9

D.L.: 2003

PLAN: EPP17616

Address: 3277 MAURICE DRIVE

Sanitary Connection:# SIZE: 100mmØ MATERIAL: PVC INV. AT R 712.75m CONNECTED

Water Connection:# SIZE: 19mmØ MATERIAL: Copper INV. AT R 712.70m

Storm Connection:# SIZE: 100mmØ MATERIAL: PVC INV. AT R 712.71m CONNECTED

Cash Receipt No's: WATER SANITARY STORM

CURB FROM PROPERTY LINE 5m PAVEMENT WIDTH 10m

HYDRO 75mm DB2 U/G CONNECTION ✓

TELEPHONE 100mm DB2 U/G CONNECTION ✓


GAS 42 PROP/P.E.

Information Sheets: REF. DWGS. L&M ENGINEERING LTD. JOB. 1273-14-04 DWGS.

Comments: CS CURB STOP CO CLEAN OUT SDW WATER SERVICE STORM SERVICE SANITARY SERVICE TCH HYDRO SERVICE CABLE SERVICE TELECOMMUNICATIONS GAS ELECTRICAL

THE INFORMATION CONTAINED HEREIN IS FOR INTERNAL USE ONLY.

NOT TO BE RELIED UPON UNLESS CONFIRMED BY THE SITE INSPECTION AND/OR INVESTIGATION

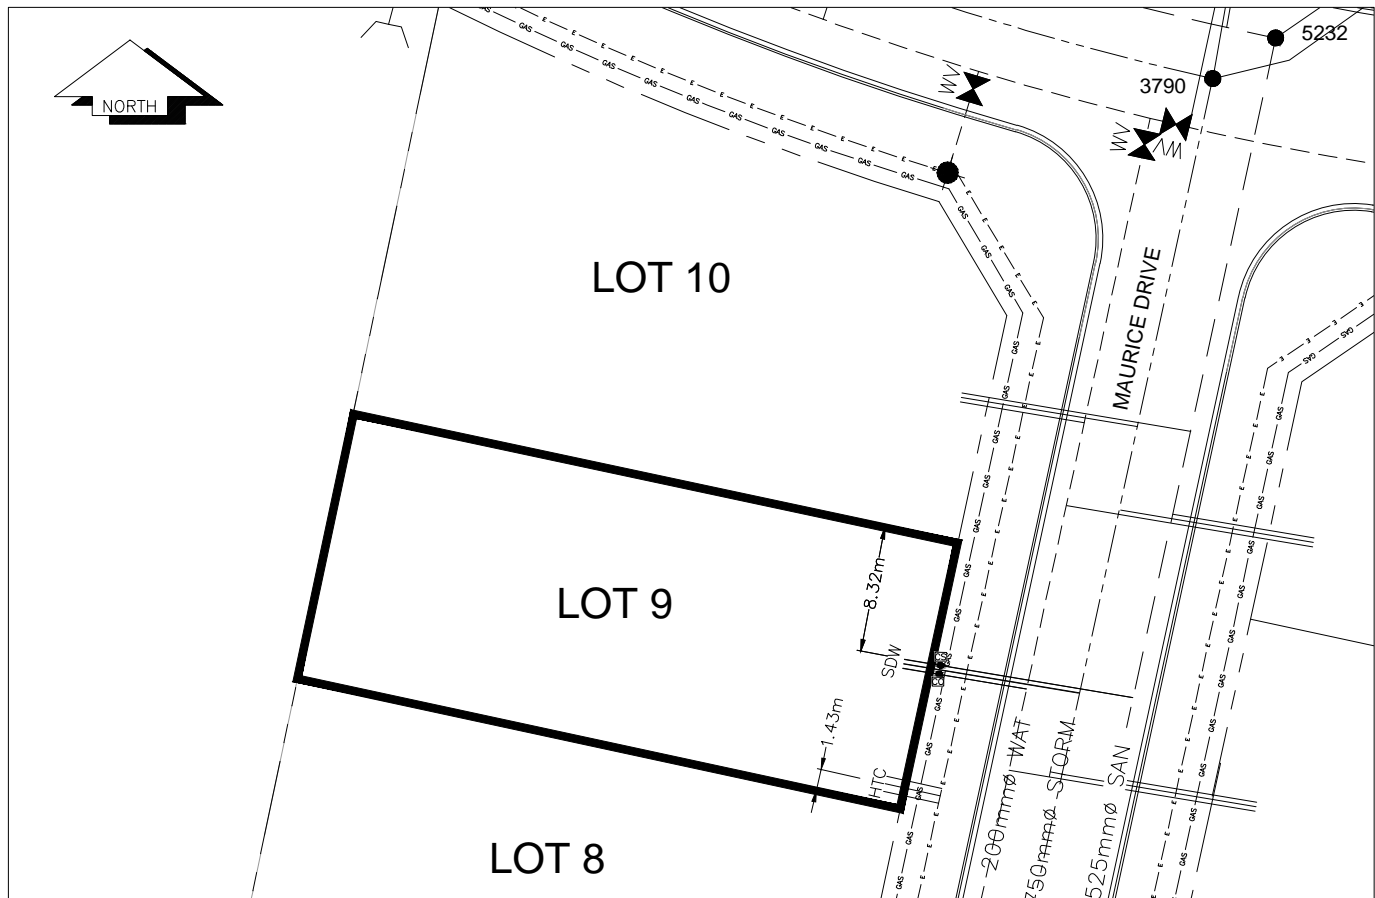

SANITARY, STORM & WATER SERVICE INVERTS	SANITARY	WATER	STORM
1. Distance from San. M.H. <u>5232</u> toward San. M.H. <u>5231</u> to lot service connection point is:	44.62m	N/A	N/A
1a.Distance from Stm. M.H. <u>3790</u> toward Stm. M.H. <u>3789</u> to lot service connection point is:	N/A	N/A	41.58m
2. Main Size at connection point is	525mmØ	200mmØ	750mmØ
3. Invert of service at main conn. stub point is	711.00m	711.46m	710.71m
4. Invert at service end is	712.81m	712.76m	712.77m
5. Cover at property line in meters	2.13m	2.26m	2.17m
6. Survey Date: MAY 2012 Book Ref.:1273-14-04 By: L&M ENGINEERING LTD			

SANITARY HISTORY:

DATE INSTALLED: JULY 2012

INSTALLED BY: SUNLAND UTILITIES LTD

WATER HISTORY:

DATE INSTALLED: JULY 2012

INSTALLED BY: SUNLAND UTILITIES LTD.

STORM HISTORY:

DATE INSTALLED: JULY 2012

INSTALLED BY: SUNLAND UTILITIES LTD.