

City of Prince George

HISTORY SHEET

PID: **028904761**

Scale: 1:500

Legal: LOT 19

D.L.: 905

PLAN: EPP17616


Address: **2496 GRAFTON STREET**

Sanitary Connection:#	SIZE: 100mmØ	MATERIAL: PVC	INV. AT \mathbb{R} 722.49m	CONNECTED
Water Connection:#	SIZE: 19mmØ	MATERIAL: Copper	INV. AT \mathbb{R} 722.49m	
Storm Connection:#	SIZE: 100mmØ	MATERIAL: PVC	INV. AT \mathbb{R} 722.49m	CONNECTED
Cash Receipt No's:	WATER	SANITARY	STORM	
CURB FROM PROPERTY LINE	5m		PAVEMENT WIDTH	10m
HYDRO	75mm DB2	U/G CONNECTION	✓	
TELEPHONE	100mm DB2	U/G CONNECTION	✓	
GAS	42 PROP/P.E.			

Information Sheets: REF. DWGS. L&M ENGINEERING LTD. JOB. 1273-14-04 DWGS.

Comments: CS CURB STOP CO CLEAN OUT WDS WATER SERVICE SWS STORM SERVICE SSS SANITARY SERVICE HSD HYDRO SERVICE CSD CABLE SERVICE TSC TELECOMMUNICATIONS E GAS E ELECTRICAL

THE INFORMATION CONTAINED HEREIN IS FOR INTERNAL USE ONLY.
NOT TO BE RELIED UPON UNLESS CONFIRMED BY THE SITE INSPECTION AND/OR INVESTIGATION

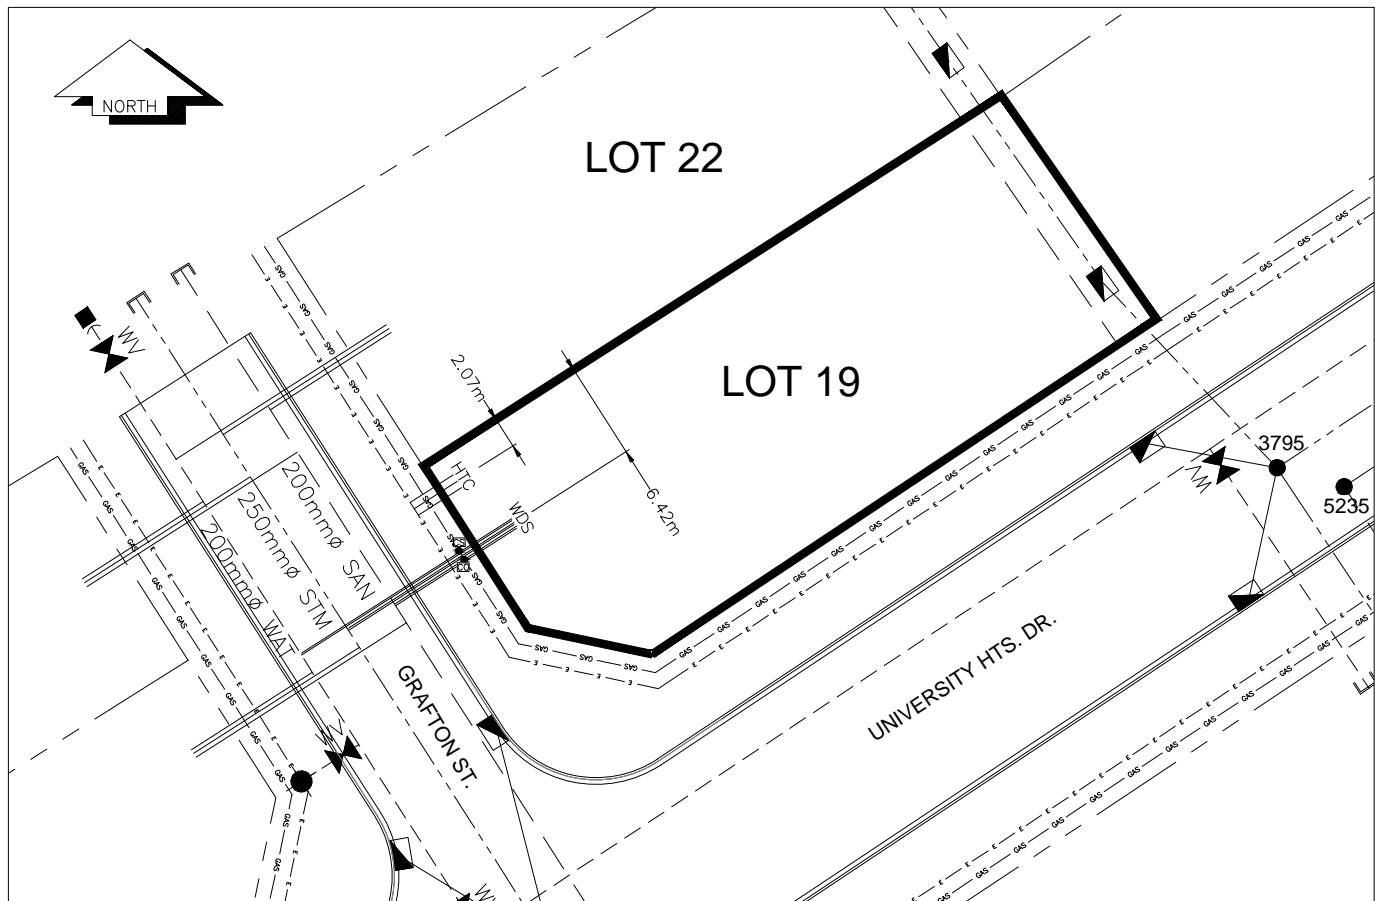

SANITARY, STORM & WATER SERVICE INVERTS	SANITARY	WATER	STORM
1. Distance from San. M.H. <u>STUB</u> toward San. M.H. <u>5236</u> to lot service connection point is:	25.95m	N/A	N/A
1a.Distance from Stm. M.H. <u>STUB</u> toward Stm. M.H. <u>3796</u> to lot service connection point is:	N/A	N/A	26.03m
2. Main Size at connection point is	200mmØ	200mmØ	250mmØ
3. Invert of service at main conn. stub point is	722.54m	721.78	722.46m
4. Invert at service end is	722.55m	722.55m	722.55m
5. Cover at property line in meters	2.23m	2.31m	2.23m
6. Survey Date: MAY 2012 Book Ref.:1273-14-04 By: L&M ENGINEERING LTD			

SANITARY HISTORY:

DATE INSTALLED: JULY 2012

INSTALLED BY: SUNLAND UTILITIES LTD

WATER HISTORY:

DATE INSTALLED: JULY 2012

INSTALLED BY: SUNLAND UTILITIES LTD.

STORM HISTORY:

DATE INSTALLED: JULY 2012

INSTALLED BY: SUNLAND UTILITIES LTD.