

City of Prince George

HISTORY SHEET

PID: **028904800**

Scale: 1:500

Legal: LOT 24

D.L.: 905

PLAN: EPP17616


Address: **2484 CHANCELLOR BOULEVARD**

Sanitary Connection:#	SIZE: 100mmØ	MATERIAL: PVC	INV. AT RL 717.84m	CONNECTED
Water Connection:#	SIZE: 19mmØ	MATERIAL: Copper	INV. AT RL 717.73m	
Storm Connection:#	SIZE: 100mmØ	MATERIAL: PVC	INV. AT RL 717.86m	CONNECTED
Cash Receipt No's:	WATER	SANITARY	STORM	
CURB FROM PROPERTY LINE	6m		PAVEMENT WIDTH	13m
HYDRO	75mm DB2	U/G CONNECTION	✓	
TELEPHONE	100mm DB2	U/G CONNECTION	✓	
GAS	42 PROP/P.E.			

Information Sheets: REF. DWGS. L&M ENGINEERING LTD. JOB. 1273-14-04 DWGS.

Comments: CS CURB STOP CO CLEAN OUT MCS WATER SERVICE STORM SERVICE SANITARY SERVICE HYDRO SERVICE CABLE SERVICE TELECOMMUNICATIONS GAS ELECTRICAL

THE INFORMATION CONTAINED HEREIN IS FOR INTERNAL USE ONLY.
NOT TO BE RELIED UPON UNLESS CONFIRMED BY THE SITE INSPECTION AND/OR INVESTIGATION

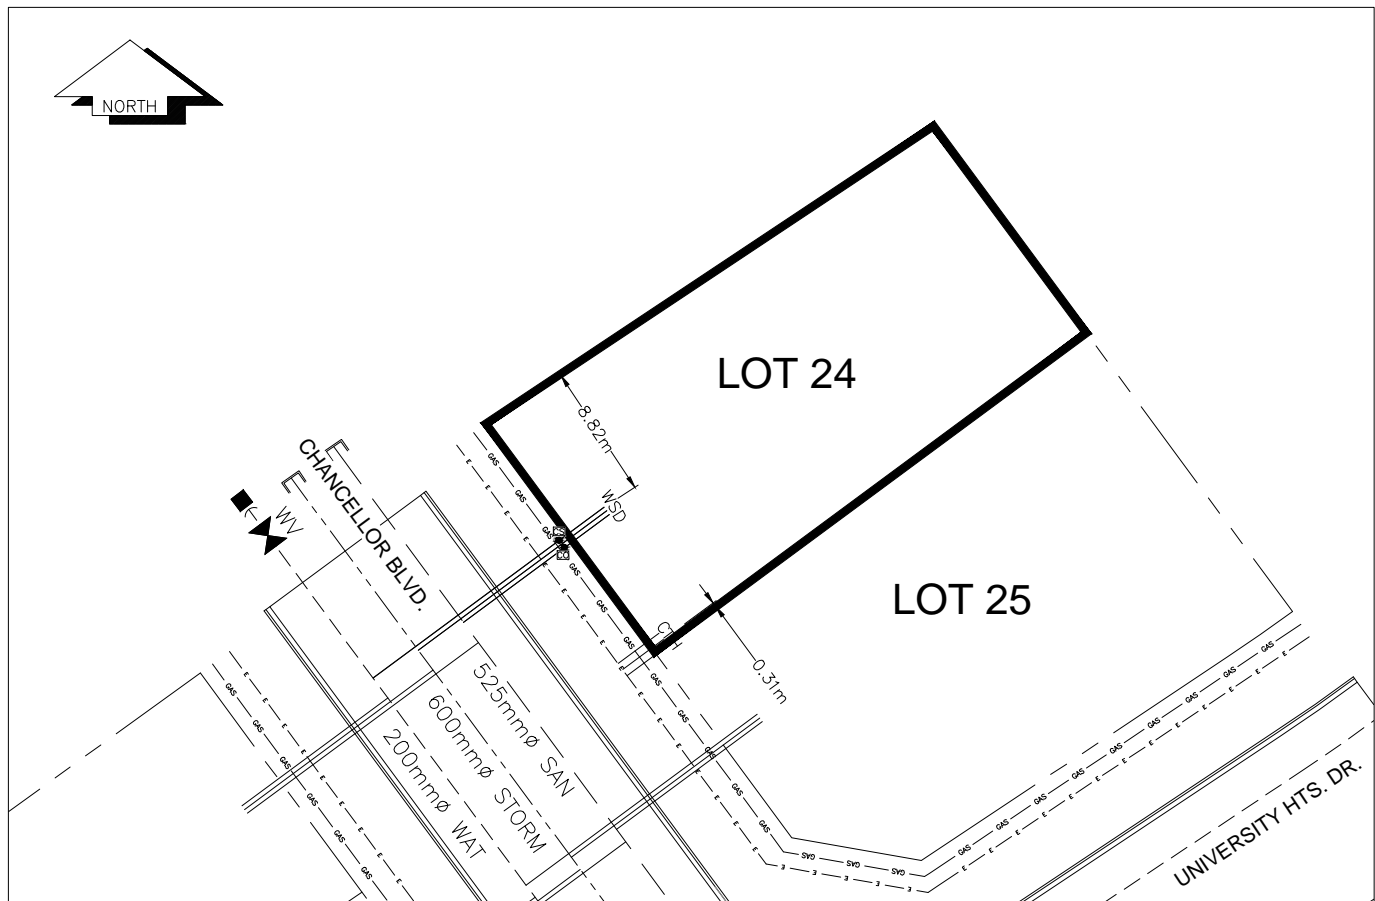

SANITARY, STORM & WATER SERVICE INVERTS	SANITARY	WATER	STORM
1. Distance from San. M.H. <u>STUB</u> toward San. M.H. <u>5234</u> to lot service connection point is:	15.09m	N/A	N/A
1a.Distance from Stm. M.H. <u>STUB</u> toward Stm. M.H. <u>3794</u> to lot service connection point is:	N/A	N/A	15.75m
2. Main Size at connection point is	525mmØ	200mmØ	600mmØ
3. Invert of service at main conn. stub point is	717.88m	717.00m	717.58m
4. Invert at service end is	717.90m	717.79m	717.92m
5. Cover at property line in meters	2.46m	2.65m	2.44m
6. Survey Date: MAY 2012 Book Ref.:1273-14-04 By: L&M ENGINEERING LTD			

SANITARY HISTORY:

DATE INSTALLED: JULY 2012

INSTALLED BY: SUNLAND UTILITIES LTD

WATER HISTORY:

DATE INSTALLED: JULY 2012

INSTALLED BY: SUNLAND UTILITIES LTD.

STORM HISTORY:

DATE INSTALLED: JULY 2012

INSTALLED BY: SUNLAND UTILITIES LTD.