
City of Prince George HISTORY SHEET

PID: 02890482	6				Scal	e: 1:500		
Legal: LOT 26					D.L.:	905	PLAN: EPP17616	
Address: 2500 CHA	NCELLOR E	BOULEVARD						
Sanitary Connection:	#	SIZE:	100mmØ	MATERIAL:	PVC	INV. AT № 716.63m	CONNECTED	
Water Connection:#		SIZE:	19mmØ	MATERIAL:	Copper	INV. AT 12 716.75m		
Storm Connection:#		SIZE	100mmØ	MATERIAL	PVC	INV. AT № 716.63m	CONNECTED	
Cash Receipt No's:		WATER		SANITARY		STORM		
CURB FROM PROPERTY LINE 6m					PAVEMENT !	WIDTH 13m		
HYDRO	75mm D	B2			U/G CONNECTION	ON		
TELEPHONE	100mm	DB2			U/G CONNECTION	ON		
GAS	42 PROI	P/P.E.						
Information Sheets:		REF. DWGS. L&M ENGINEERING LTD. JOB. 1273-14-04 DWGS.						
Comments:		CURB STOP CLEAN OUT		WATER SERVICE STORM SERVICE SANITARY SERV	ICE =	HYDRO SERVICE CABLE SERVICE TELECOMMUNICASTION	GAS E ELECTRICAL	

THE INFORMATION CONTAINED HEREIN IS FOR INTERNAL USE ONLY.

NOT TO BE RELIED UPON UNLESS CONFIRMED BY THE SITE INSPECTION AND/OR INVESTIGATION

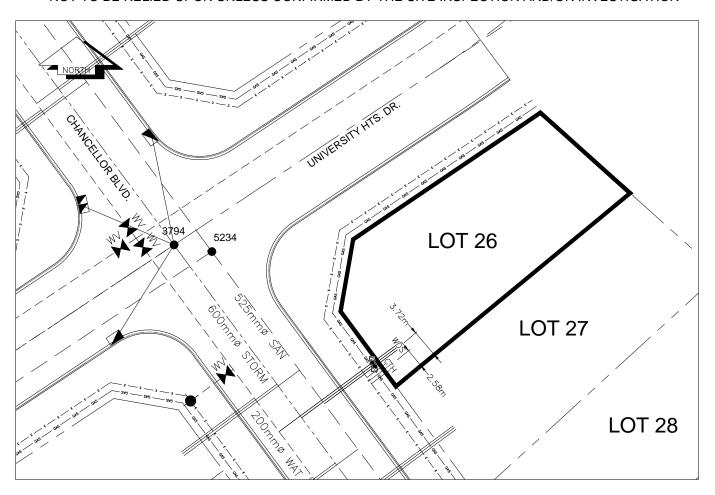

SANITARY, STORM & WATER SERVICE INVERTS	SANITARY	WATER	STORM
Distance from San. M.H. <u>5234</u> toward San. M.H. <u>5233</u> to lot service connection point is:	24.43m	N/A	N/A
1a.Distance from Stm. M.H. 3794 toward Stm. M.H. 3793 to lot service connection point is:	N/A	N/A	27.56m
2. Main Size at connection point is	525mmØ	200mmØ	600mmØ
3. Invert of service at main conn. stub point is	716.24m	715.48m	715.95m
4. Invert at service end is	716.69m	716.81m	716.69m
5. Cover at property line in meters	2.37m	2.33m	2.37m
6. Survey Date: MAY 2012 Book Ref.: 1273-14-04 By: L&M ENGINEERING LTD			
SANITARY HISTORY:			
DATE INSTALLED: JULY 2012			
INSTALLED BY: SUNLAND UTILITIES LTD			
WATER HIGTORY			
WATER HISTORY:			
DATE INSTALLED: JULY 2012			
INSTALLED BY: SUNLAND UTILITIES LTD.			
STORM HISTORY:			
DATE INSTALLED: JULY 2012			
INSTALLED BY: SUNLAND UTILITIES LTD.			
INSTALLED DT. SUNLAND STILLING ETD.			