
## City of Prince George HISTORY SHEET

PID:	028904842					S	cale: 1:500	)		
Legal:	LOT 28					С	).L.: 905		PLAN:	EPP17616
Address:	2584 CHANG	ELLOR BOUL	EVARD							
Sanitary	Connection:#		SIZE:	100mmØ	MATERIAL:	PVC	INV.	AT PL 716.29m	CONNE	ECTED
Water Co	onnection:#		SIZE:	19mmØ	MATERIAL:	Copper	INV. A	AT P_ 716.40m		
Storm Co	onnection:#		SIZE	100mmØ	MATERIAL	PVC	INV.	AT P_ 716.32m	CONNE	ECTED
Cash Re	ceipt No's:			WATER		SANITARY		:	STORM	
CURB F	ROM PROPER	TY LINE	6m					PAVEMENT	WIDTH	13m
HYDRO		75mm DB2				U/G CONNEC	CTION	/		
TELEPH	ONE	100mm DB2				U/G CONNEC	CTION	/		
GAS		42 PROP/P.E	i.							
Informati	on Sheets:	RE	F. DWGS.	L&M ENGINEE	RING LTD. JOB.	1273-14-04	DWGS.			
Commen	ts:	CS CUR			WATER SERVICE STORM SERVICE SANITARY SERV	ICE	— ∓ HYDR — ⊖ CABL TELE	O SERVICE E SERVICE COMMUNICASTIOI	NS — E —	- GAS - ELECTRICAL

THE INFORMATION CONTAINED HEREIN IS FOR INTERNAL USE ONLY.

NOT TO BE RELIED UPON UNLESS CONFIRMED BY THE SITE INSPECTION AND/OR INVESTIGATION

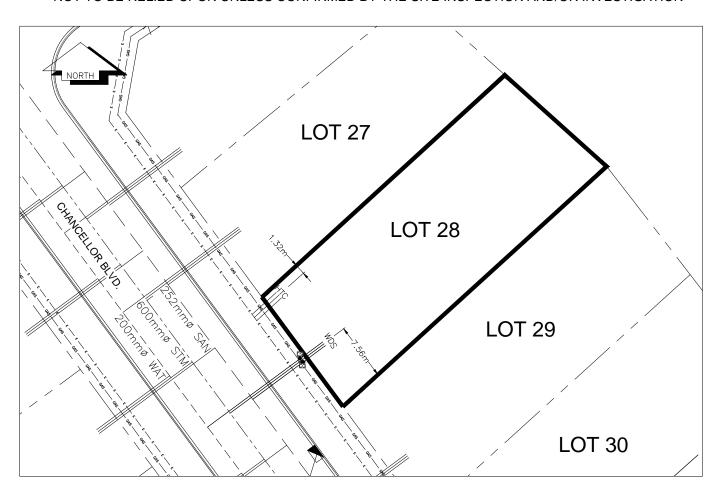

SANITARY, STORM & WATER SERVICE INVERTS	SANITARY	WATER	STORM
1. Distance from San. M.H. <u>5234</u> toward San. M.H. <u>5233</u> to lot service connection point is:	56.83m	N/A	N/A
1a.Distance from Stm. M.H. <u>3794</u> toward Stm. M.H. <u>3793</u> to lot service connection point is:	N/A	N/A	59.77m
2. Main Size at connection point is	525mmØ	200mmØ	600mmØ
3. Invert of service at main conn. stub point is	715.82m	715.27m	715.50m
4. Invert at service end is	716.35m	716.46m	716.38m
5. Cover at property line in meters	2.36m	2.33m	2.36m
6. Survey Date: MAY 2012 Book Ref.: 1273-14-04 By: L&M ENGINEERING LTD			
SANITARY HISTORY:			
DATE INSTALLED: JULY 2012			
INSTALLED BY: SUNLAND UTILITIES LTD			
WATER HISTORY:			
DATE INSTALLED: JULY 2012			
INSTALLED BY: SUNLAND UTILITIES LTD.			
INSTALLED BY. SUNLAND UTILITIES LTD.			
STORM HISTORY:			
DATE INSTALLED: JULY 2012			
INSTALLED BY: SUNLAND UTILITIES LTD.			