

City of Prince George

HISTORY SHEET

PID: **028904851**

Scale: 1:500

Legal: LOT 29

D.L.: 905

PLAN: EPP17616

Address: **2606 CHANCELLOR BOULEVARD**

Sanitary Connection:# SIZE: 100mmØ MATERIAL: PVC INV. AT \mathbb{R} 716.11m CONNECTED

Water Connection:# SIZE: 19mmØ MATERIAL: Copper INV. AT \mathbb{R} 716.11m

Storm Connection:# SIZE: 100mmØ MATERIAL: PVC INV. AT \mathbb{R} 716.11m CONNECTED

Cash Receipt No's: WATER SANITARY STORM

CURB FROM PROPERTY LINE 6m PAVEMENT WIDTH 13m

HYDRO 75mm DB2 U/G CONNECTION ✓


TELEPHONE 100mm DB2 U/G CONNECTION ✓

GAS 42 PROP/P.E.

Information Sheets: REF. DWGS. L&M ENGINEERING LTD. JOB. 1273-14-04 DWGS.

Comments: CS CURB STOP CO CLEAN OUT SOW WATER SERVICE STORM SERVICE SANITARY SERVICE HYDRO SERVICE CABLE SERVICE TELECOMMUNICATIONS GAS ELECTRICAL

THE INFORMATION CONTAINED HEREIN IS FOR INTERNAL USE ONLY.
NOT TO BE RELIED UPON UNLESS CONFIRMED BY THE SITE INSPECTION AND/OR INVESTIGATION

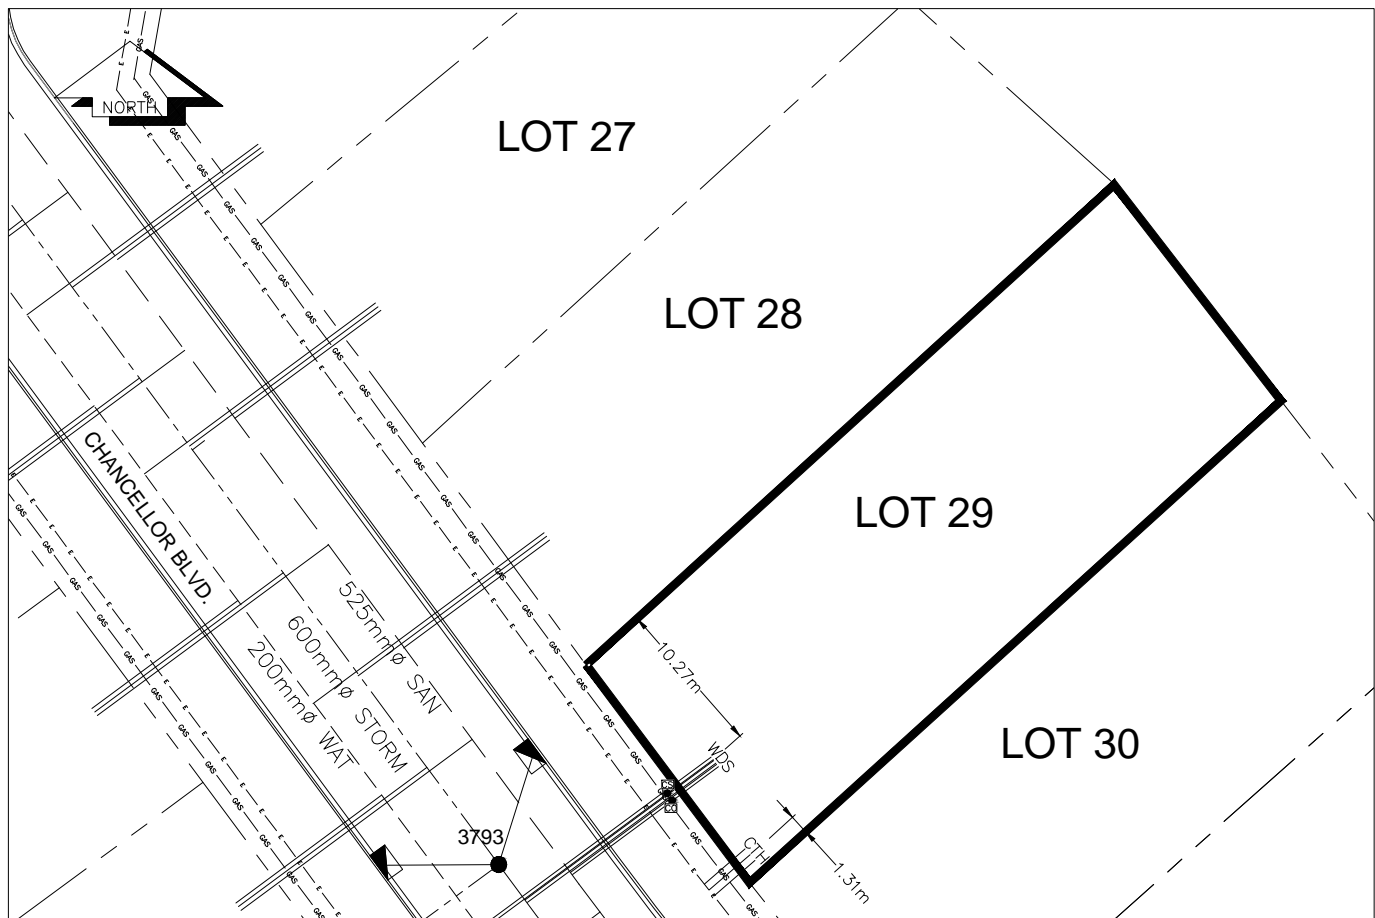

SANITARY, STORM & WATER SERVICE INVERTS	SANITARY	WATER	STORM
1. Distance from San. M.H. <u>5234</u> toward San. M.H. <u>5233</u> to lot service connection point is:	75.69m	N/A	N/A
1a.Distance from Stm. M.H. <u>3793</u> toward Stm. M.H. <u>3792</u> to lot service connection point is:	N/A	N/A	2.93m
2. Main Size at connection point is	525mmØ	200mmØ	600mmØ
3. Invert of service at main conn. stub point is	715.66m	715.00m	715.37m
4. Invert at service end is	716.17m	716.17m	716.17m
5. Cover at property line in meters	2.40m	2.48m	2.40m
6. Survey Date: MAY 2012 Book Ref.:1273-14-04 By: L&M ENGINEERING LTD			

SANITARY HISTORY:

DATE INSTALLED: JULY 2012

INSTALLED BY: SUNLAND UTILITIES LTD

WATER HISTORY:

DATE INSTALLED: JULY 2012

INSTALLED BY: SUNLAND UTILITIES LTD.

STORM HISTORY:

DATE INSTALLED: JULY 2012

INSTALLED BY: SUNLAND UTILITIES LTD.